


17 State Street

Suite 3300 - 14,900 RSF

Floor 33

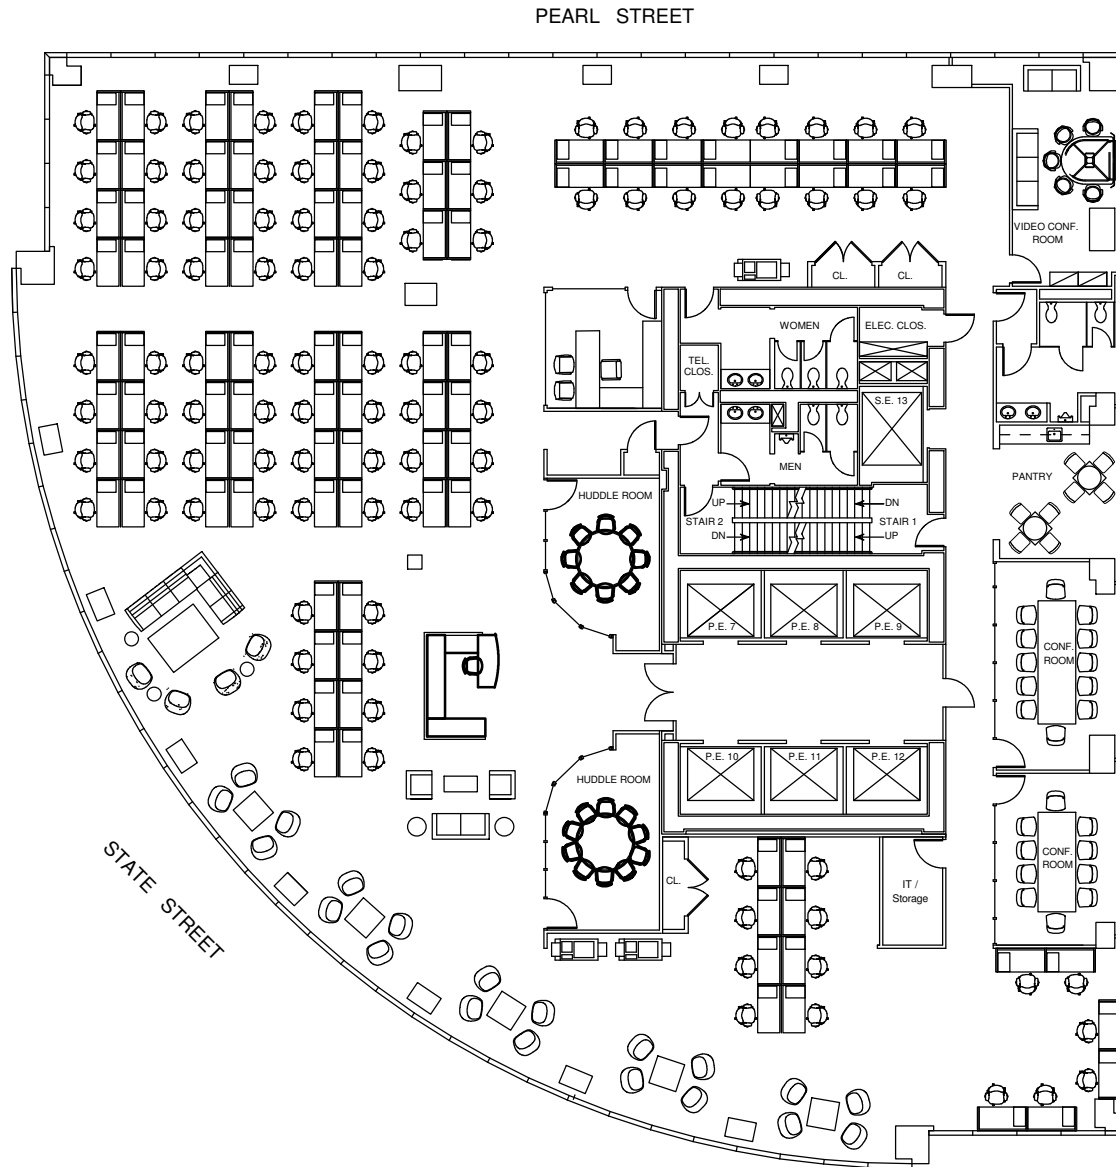

WORK STATIONS	100
RECEPTION	1
CONFERENCE ROOM	2
HUDDLE ROOM	2
VIDEO CONF. ROOM	1
PANTRY	1
OFFICE	1
IT/STORAGE	1
COAT CLOSET	3
TOTAL HEAD COUNT	101

