


390 Park Avenue

Suite 1510 - 10,726 RSF

Floor 15

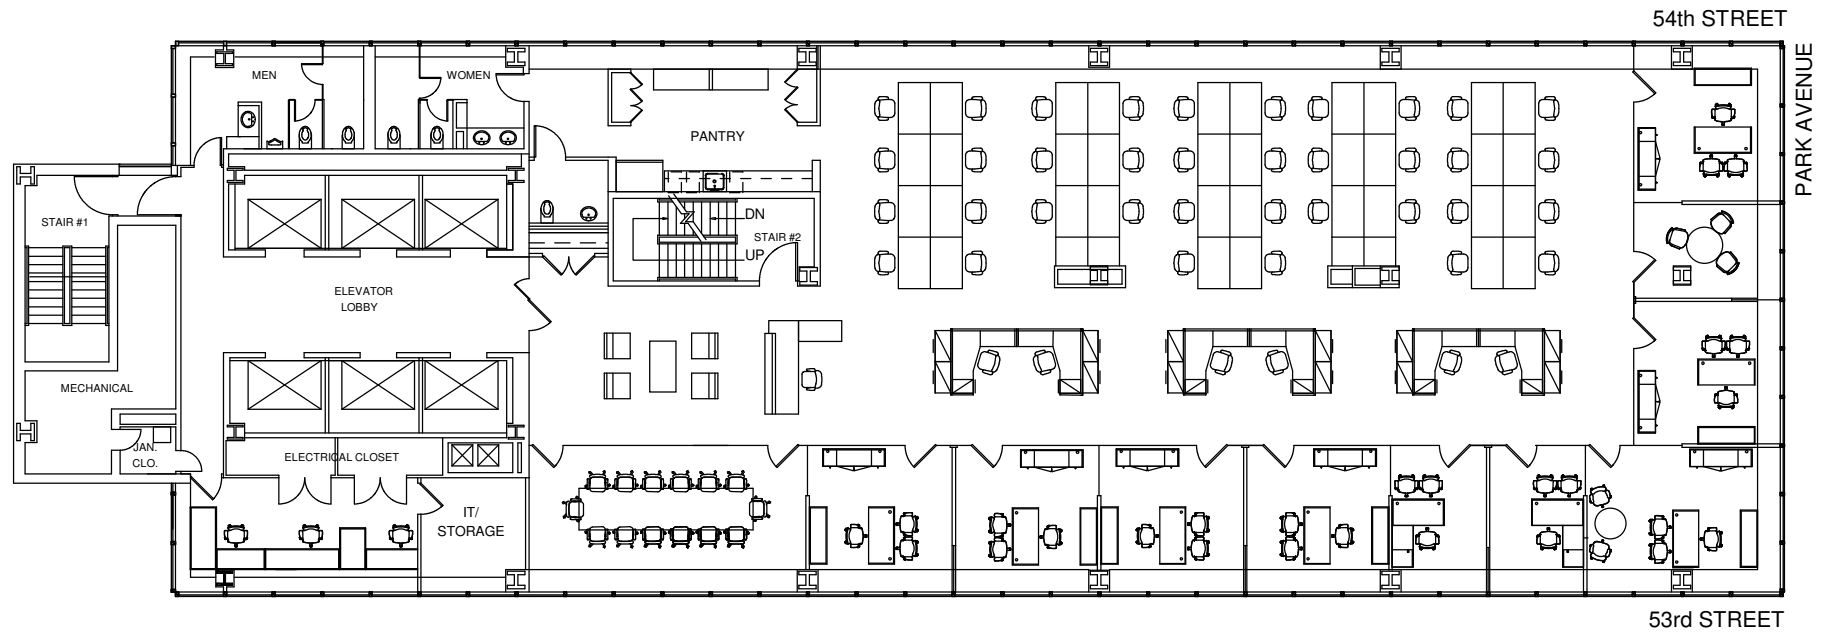

Date Printed: 1/16/2019

RFR
RFR REALTY LLC

For complete listing, visit
www.rfrspace.com



Not to scale. All dimensions and conditions
are approximate and for information only.