


375 Park Avenue

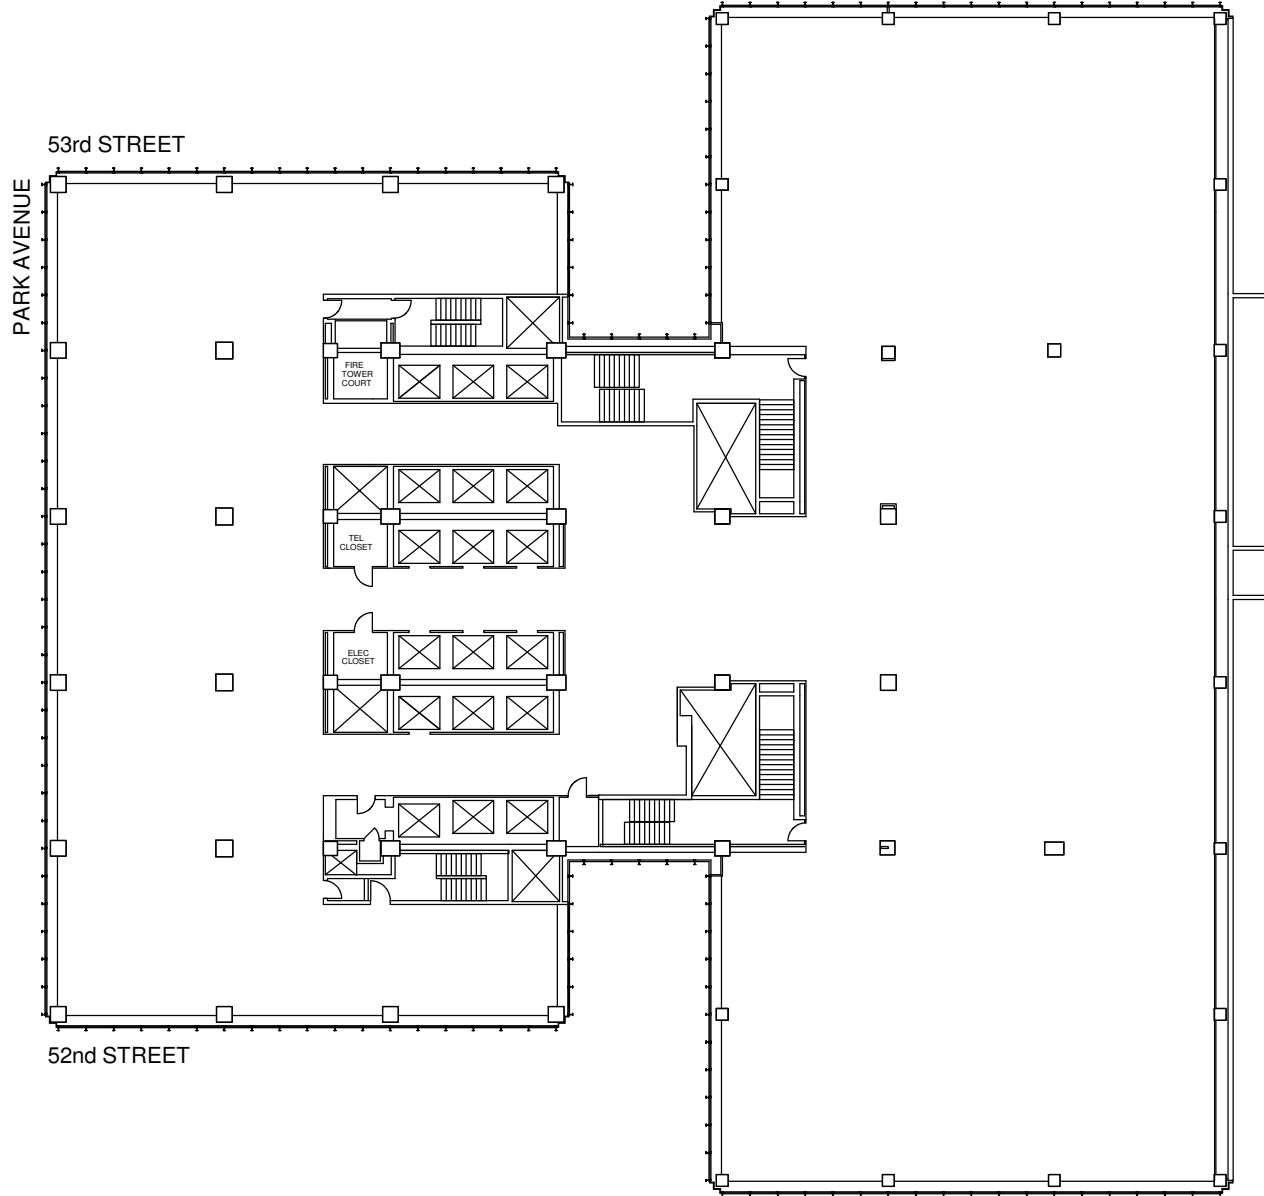


Date Printed: 1/17/2019

RFR
RFR REALTY LLC

For complete listing, visit
www.rfrspace.com




Not to scale. All dimensions and conditions
are approximate and for information only.

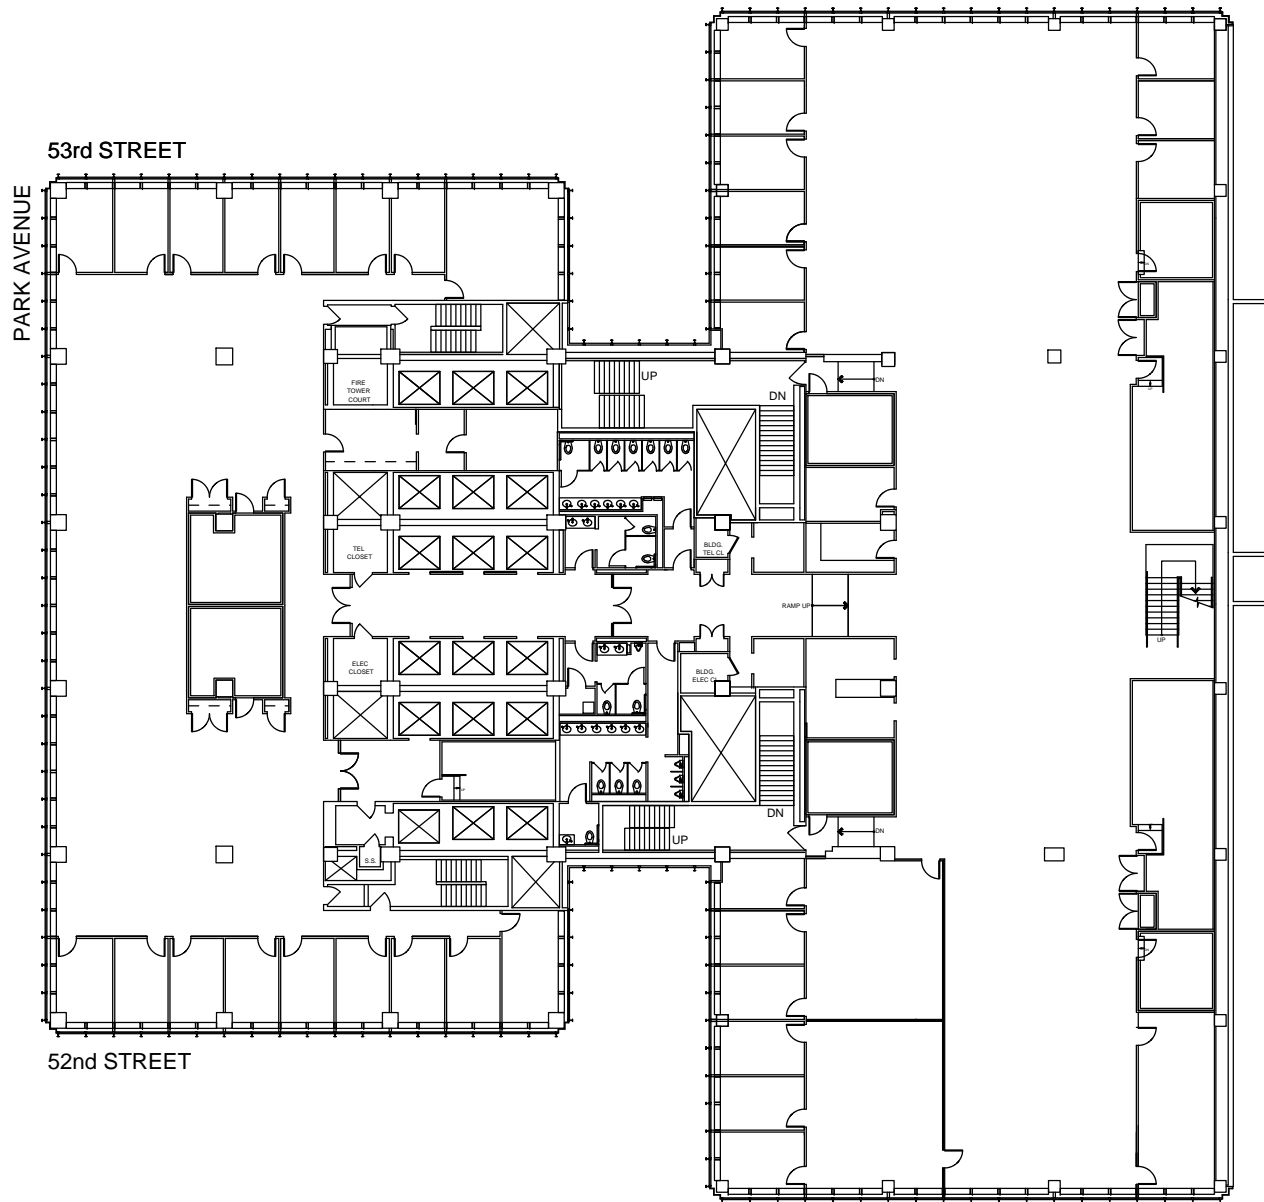


Date Printed: 5/8/2012



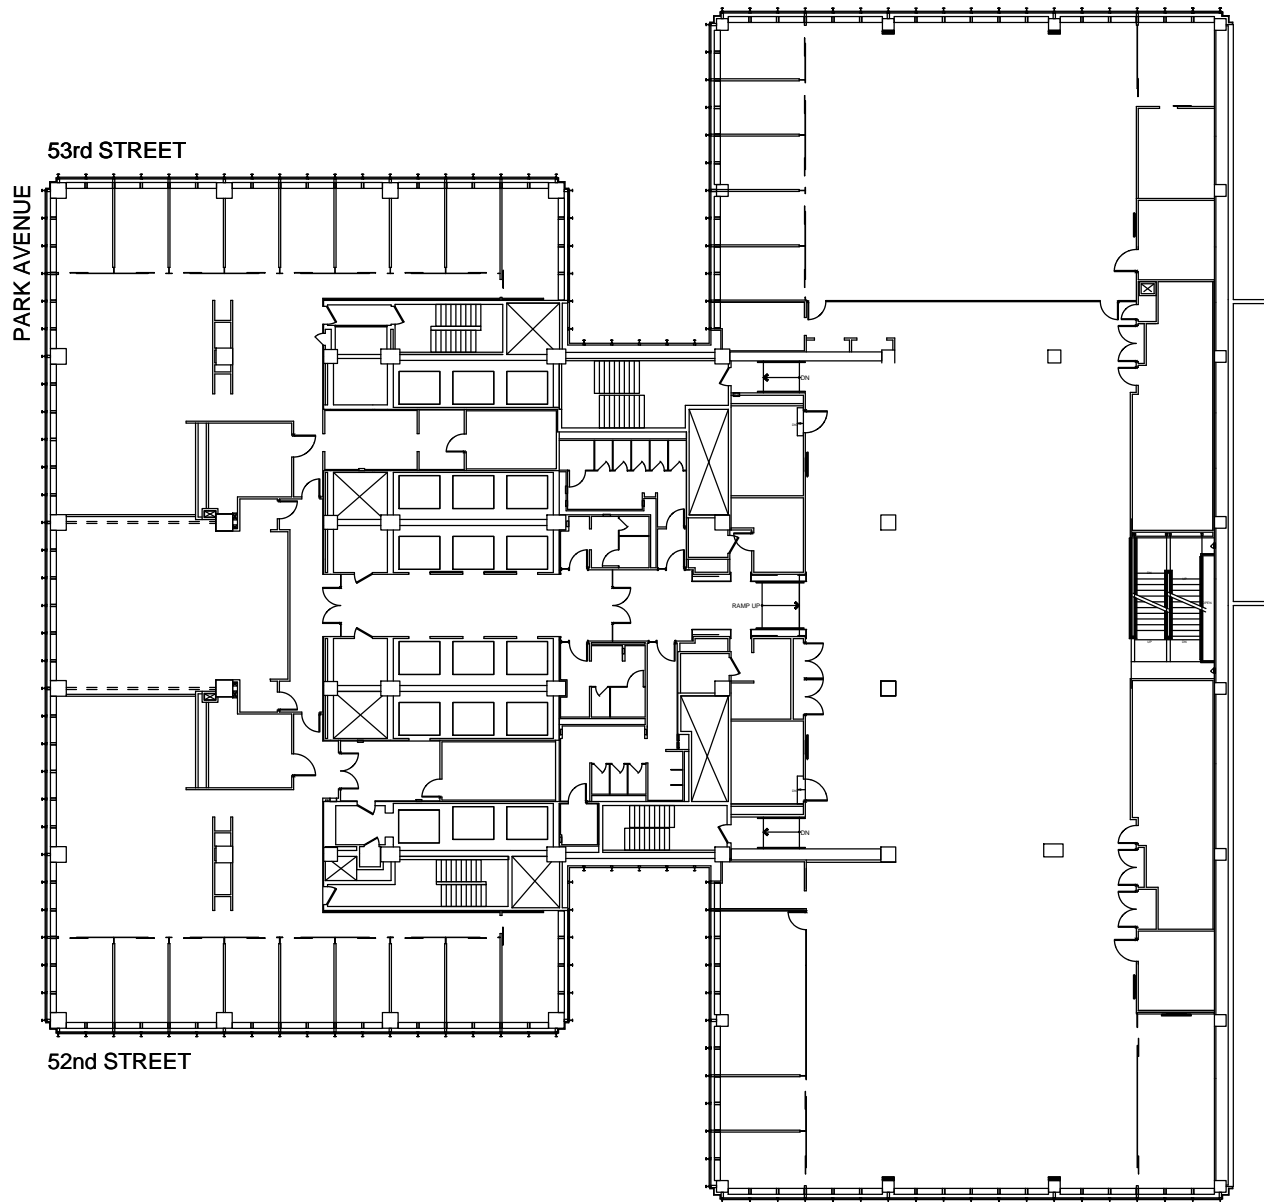


Date Printed: 5/8/2012

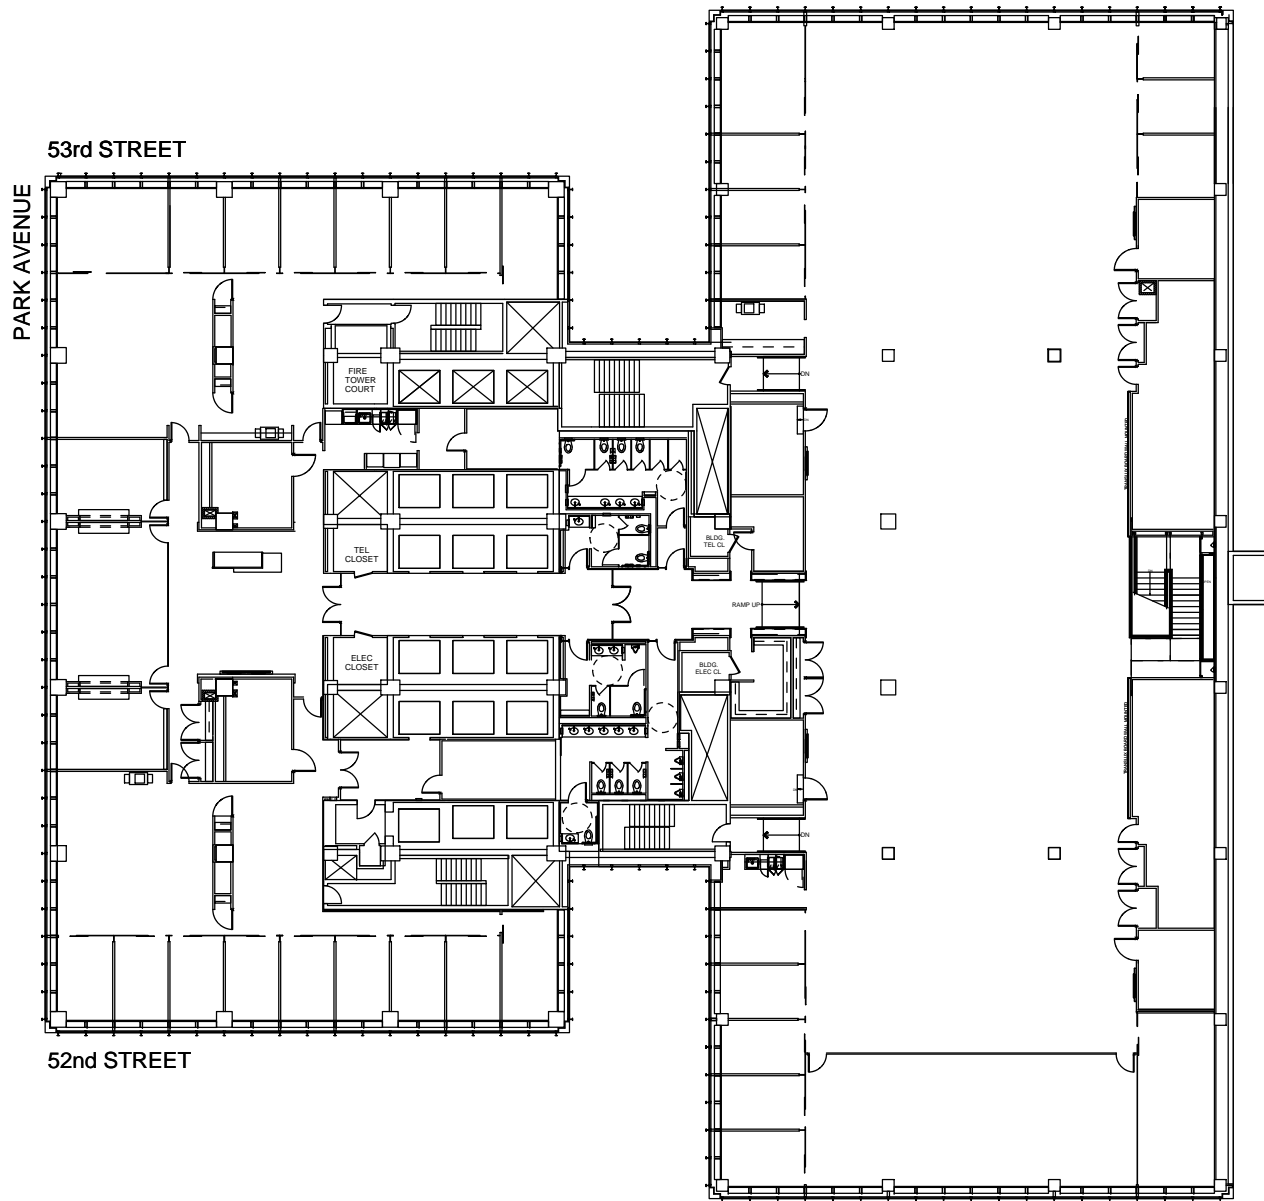

Date Printed: 5/8/2012



375 Park Avenue

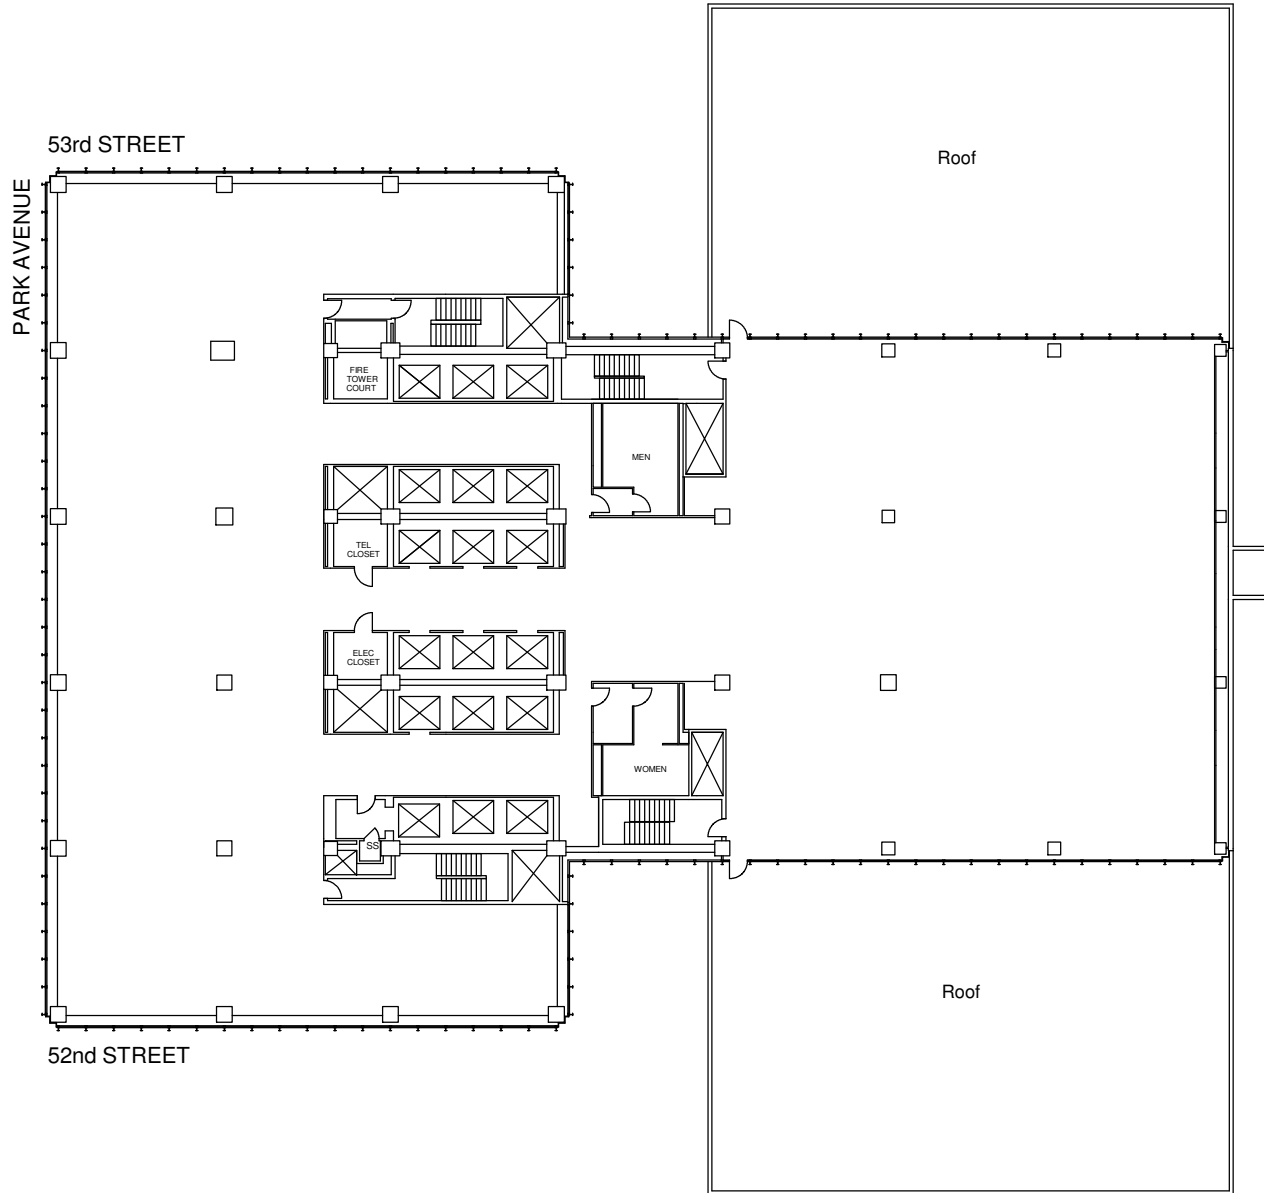


Date Printed: 7/18/2019

RFR
RFR REALTY LLC


For complete listing, visit
www.rfrspace.com



Not to scale. All dimensions and conditions
are approximate and for information only.

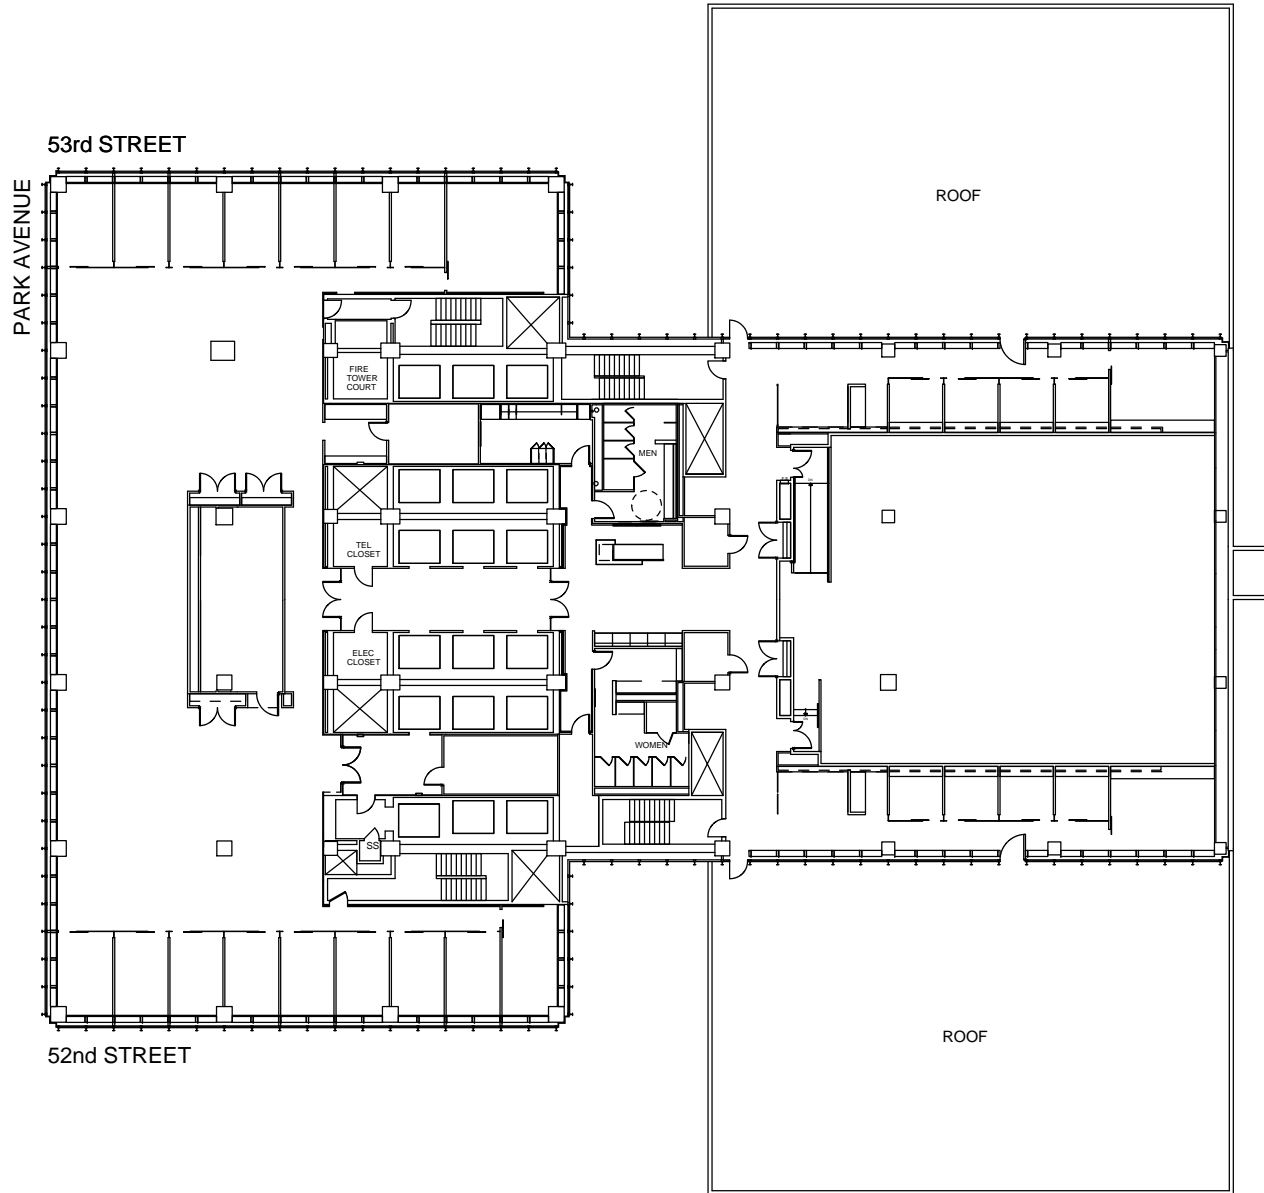

375 Park Avenue

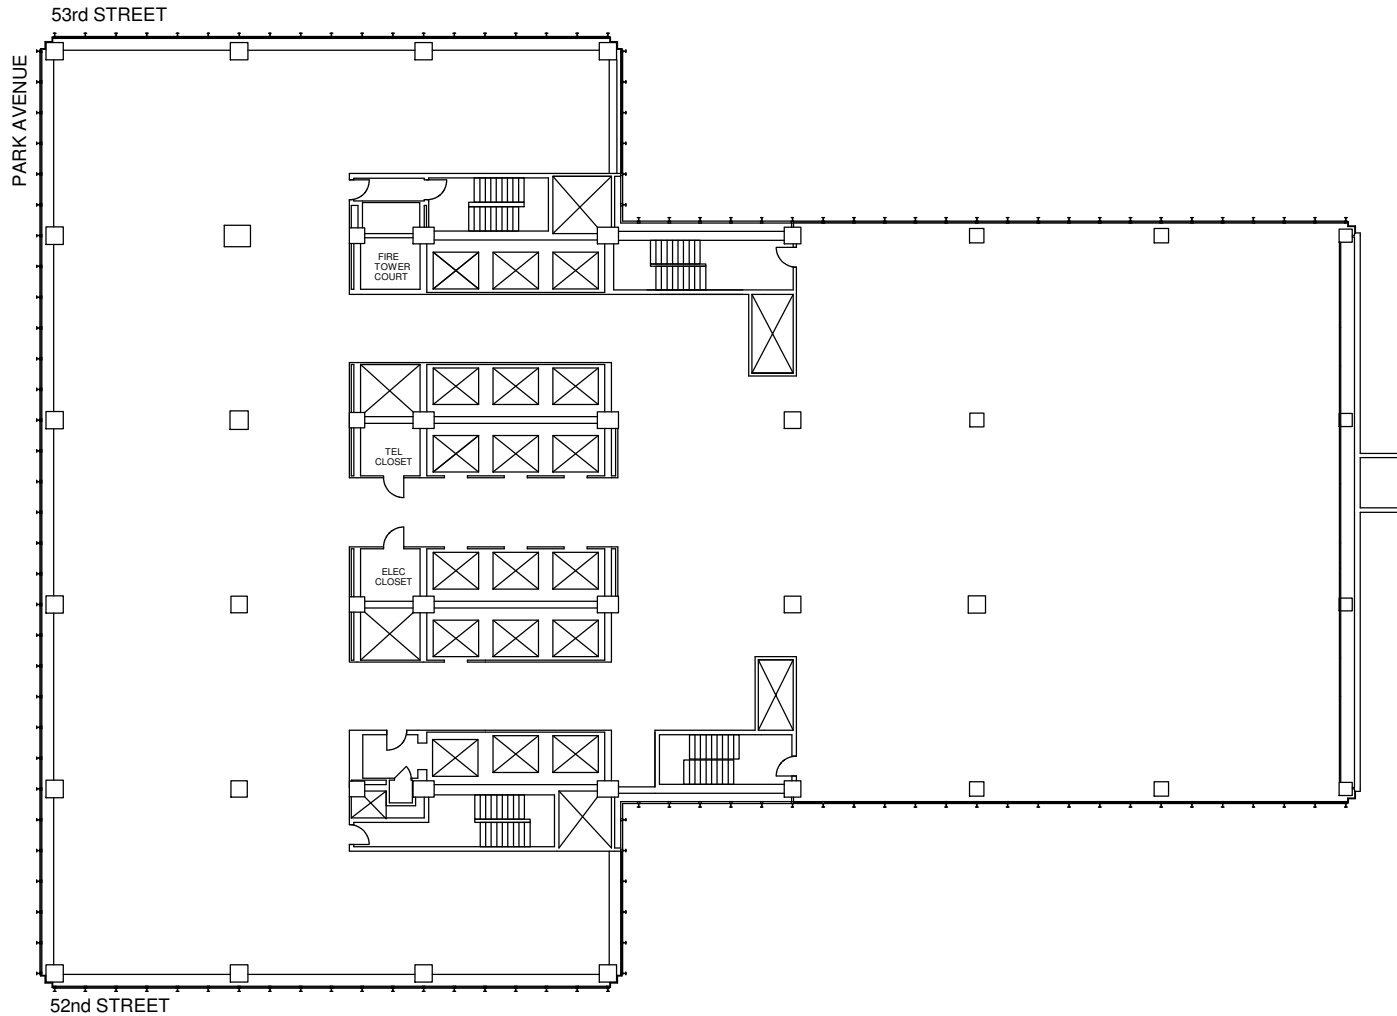


Date Printed: 1/17/2019

RFR
RFR REALTY LLC

For complete listing, visit
www.rfrspace.com



Not to scale. All dimensions and conditions
are approximate and for information only.

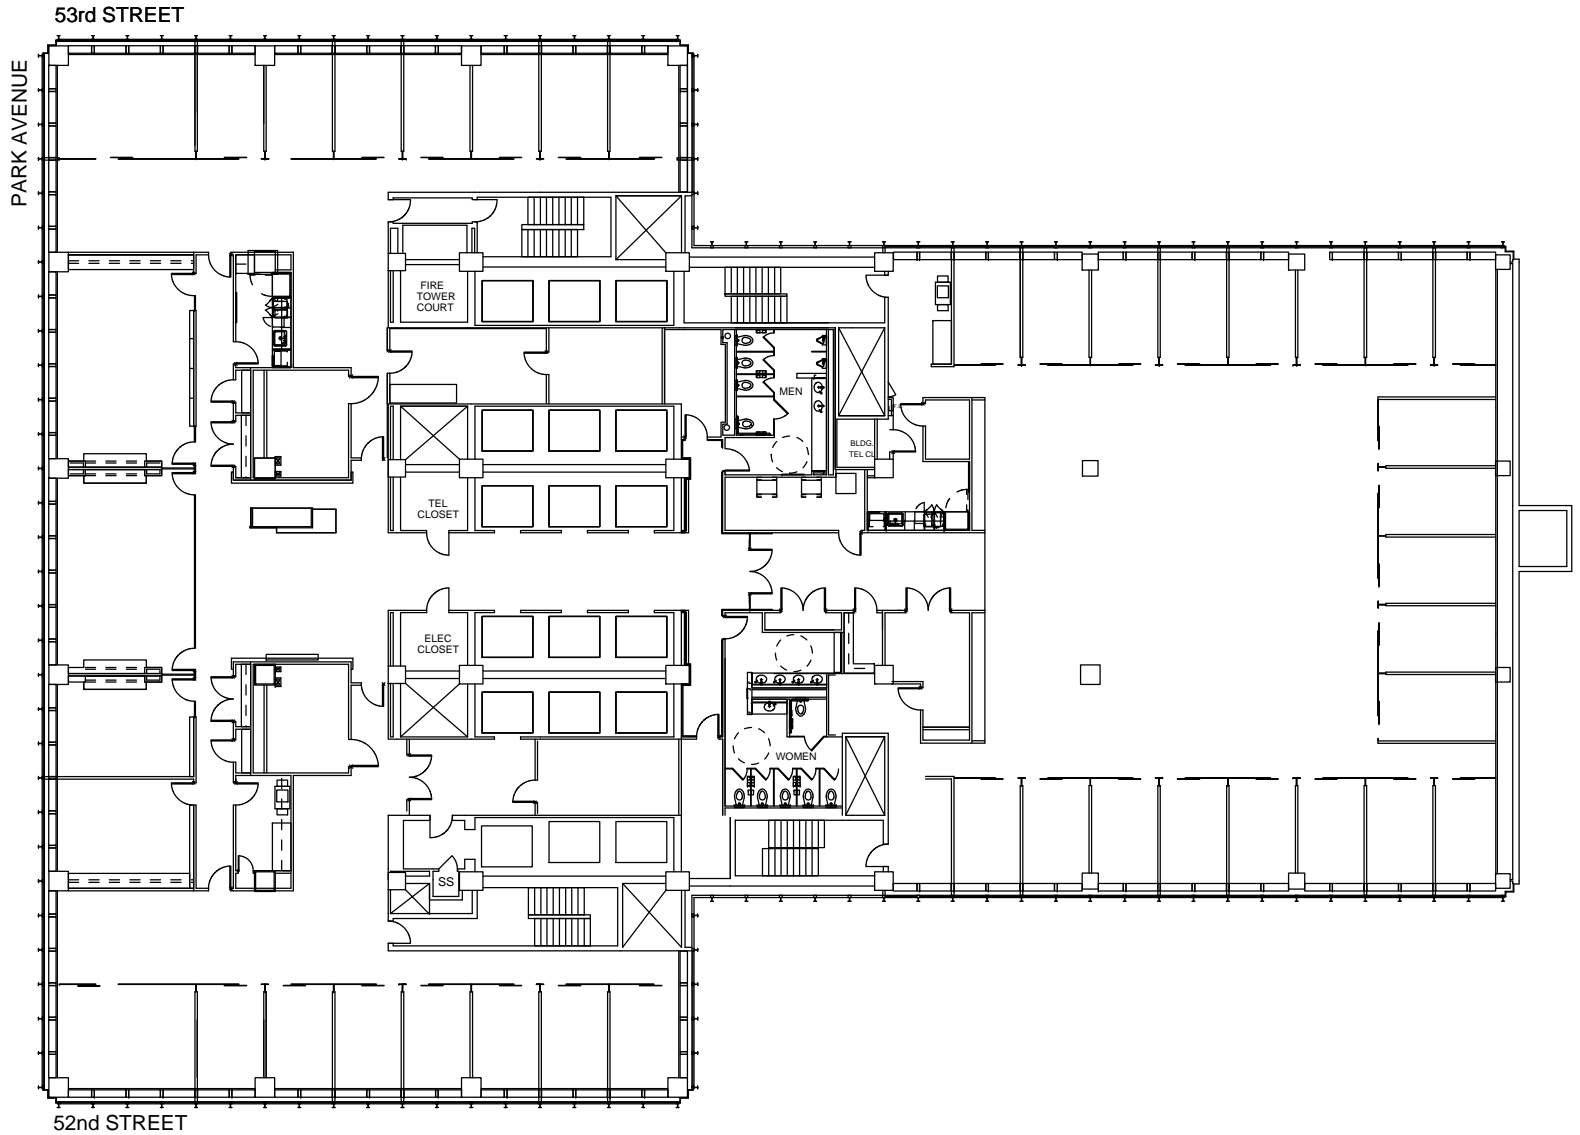

Date Printed: 5/8/2012



