




Date Printed: 5/8/2012




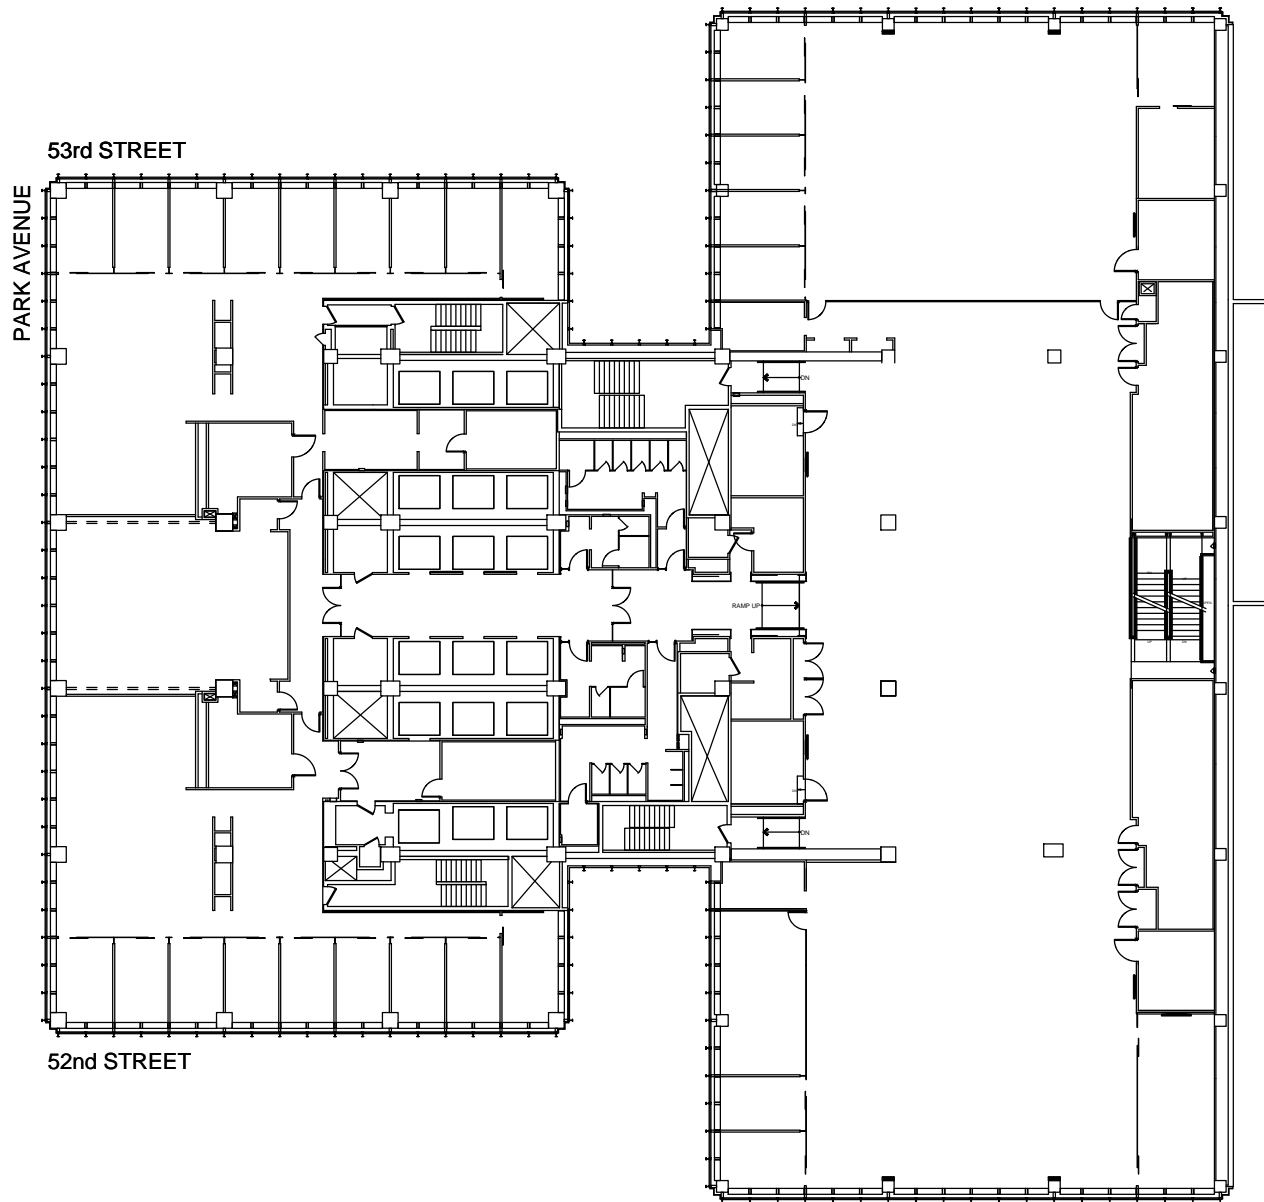



Date Printed: 5/8/2012

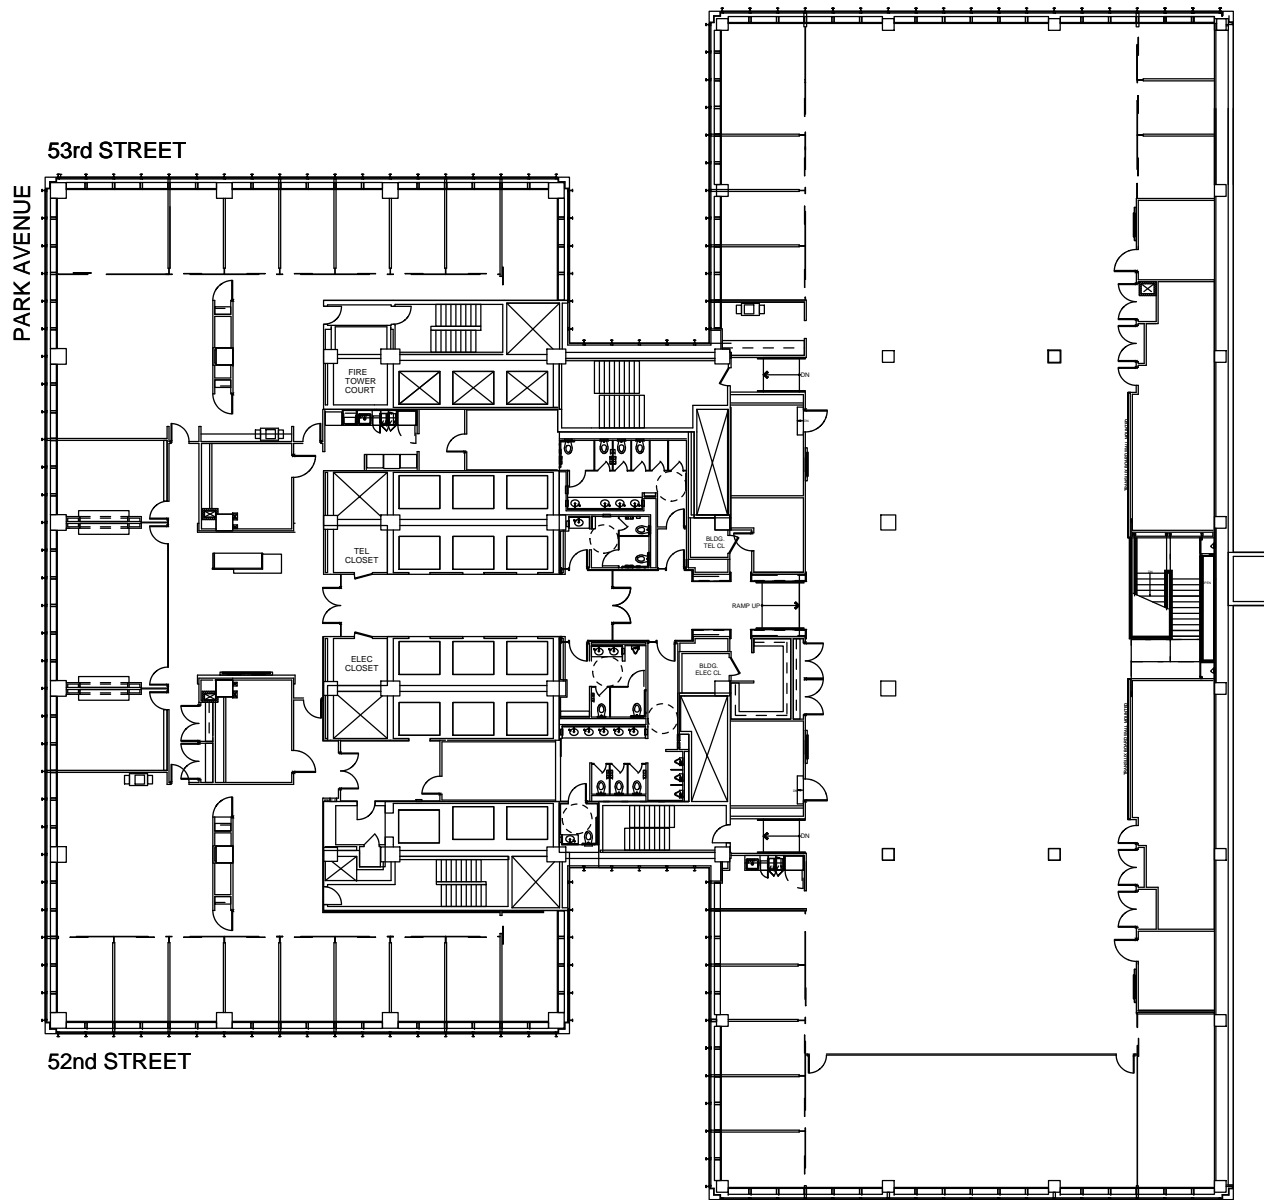

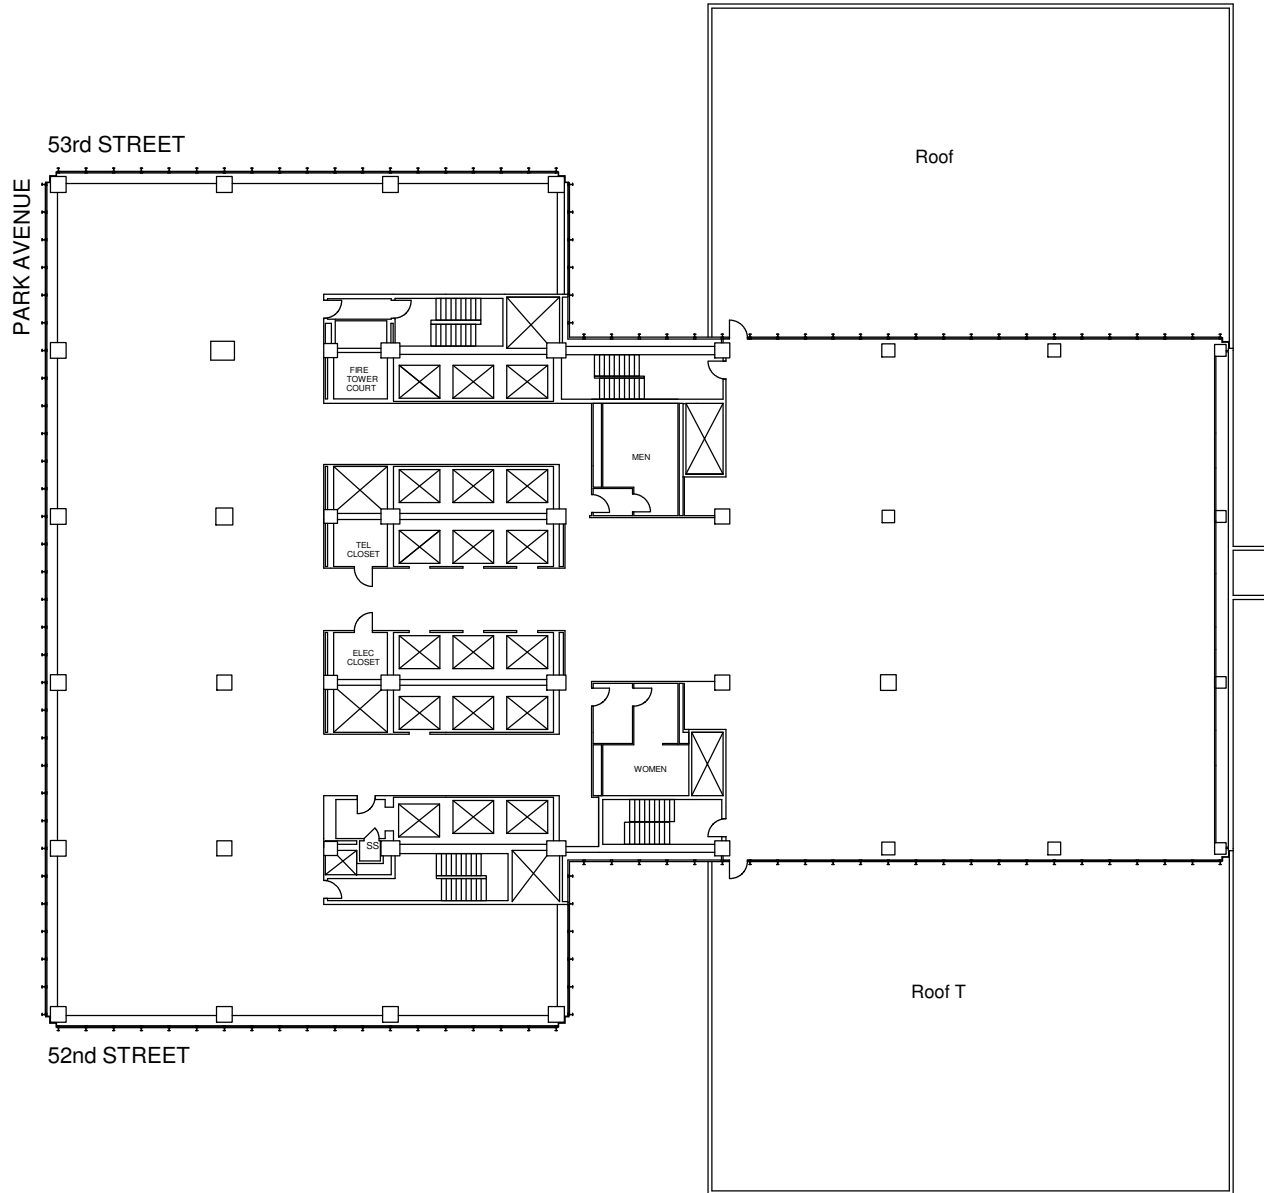

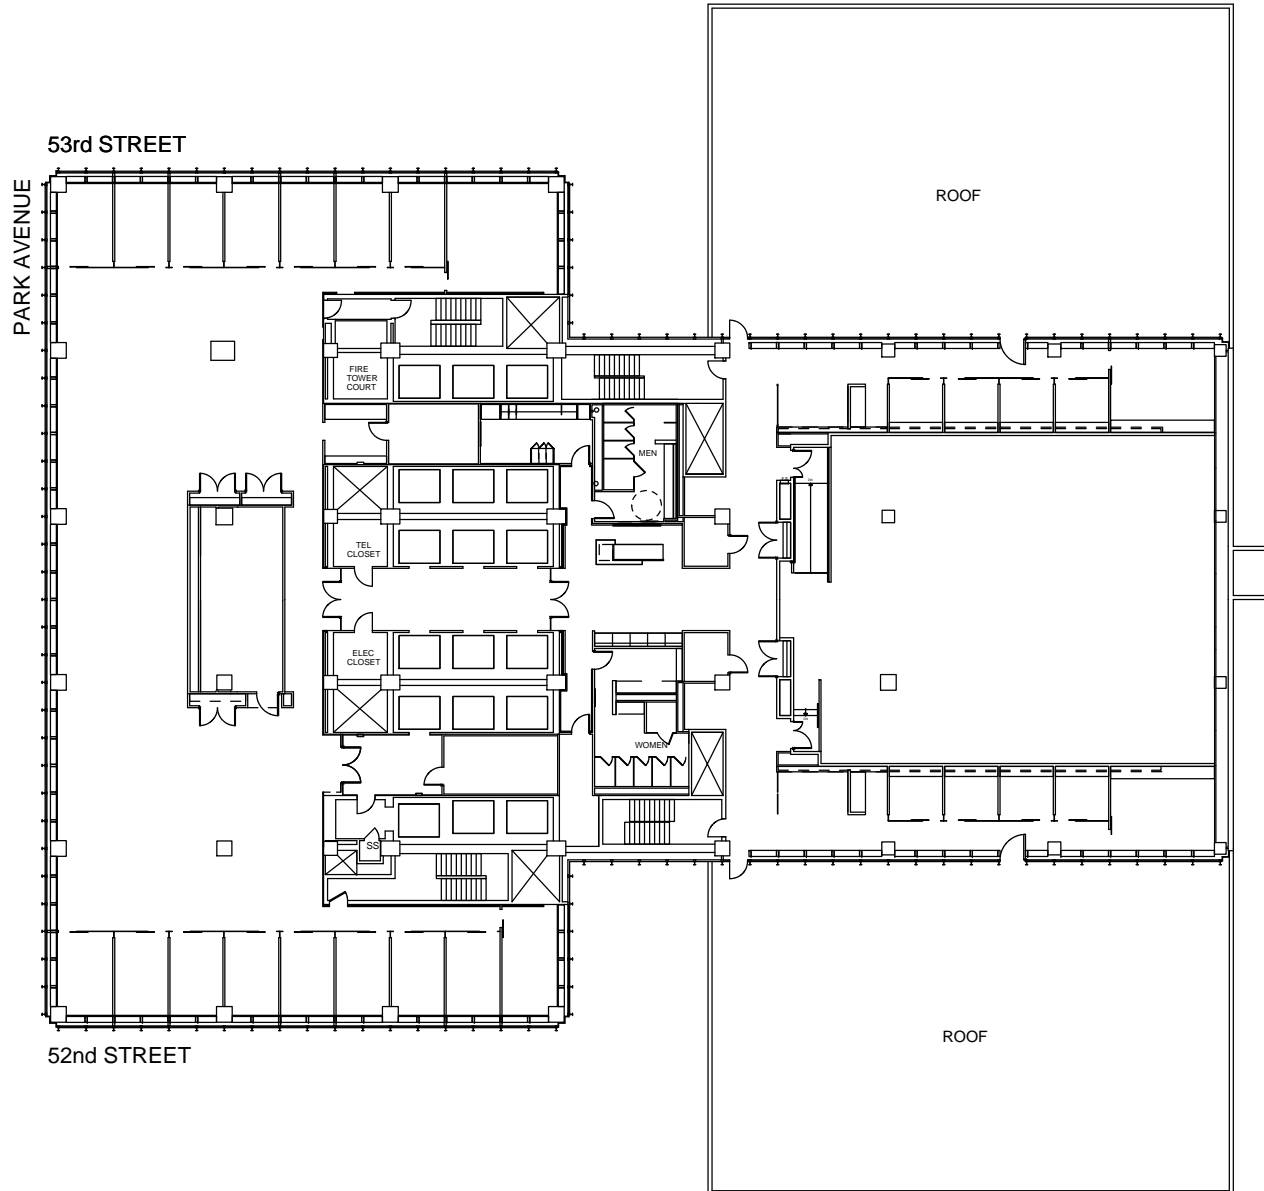

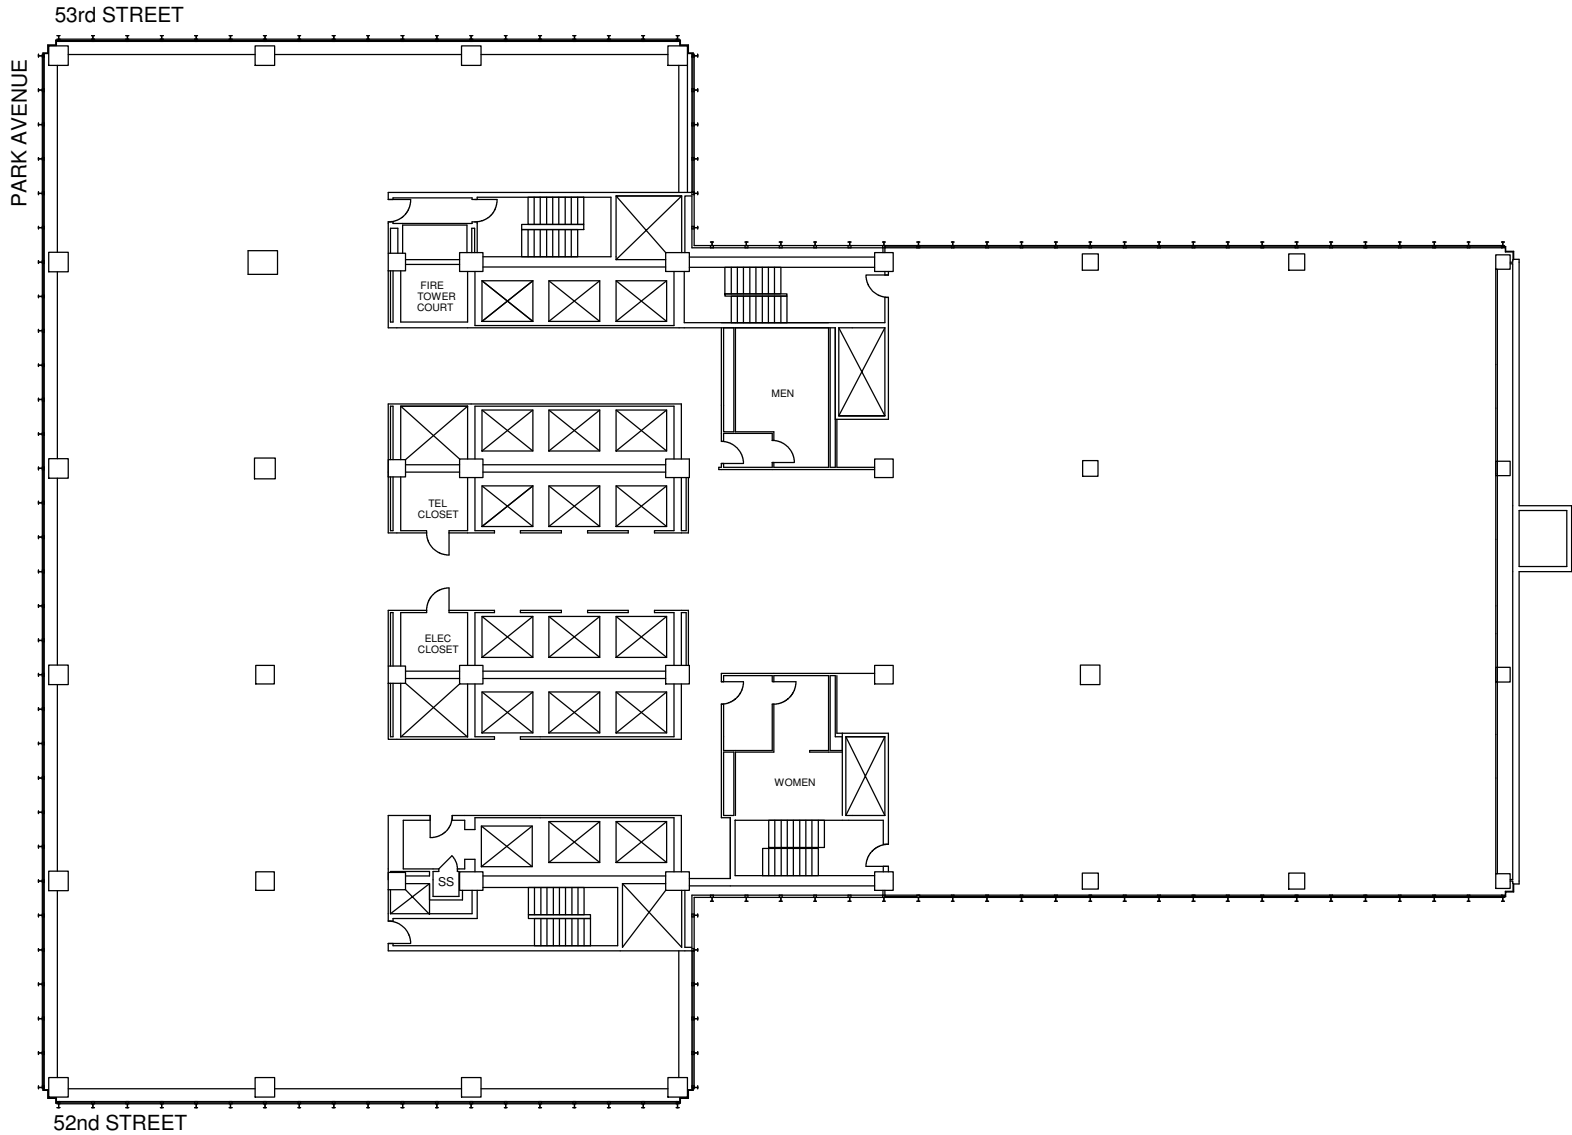

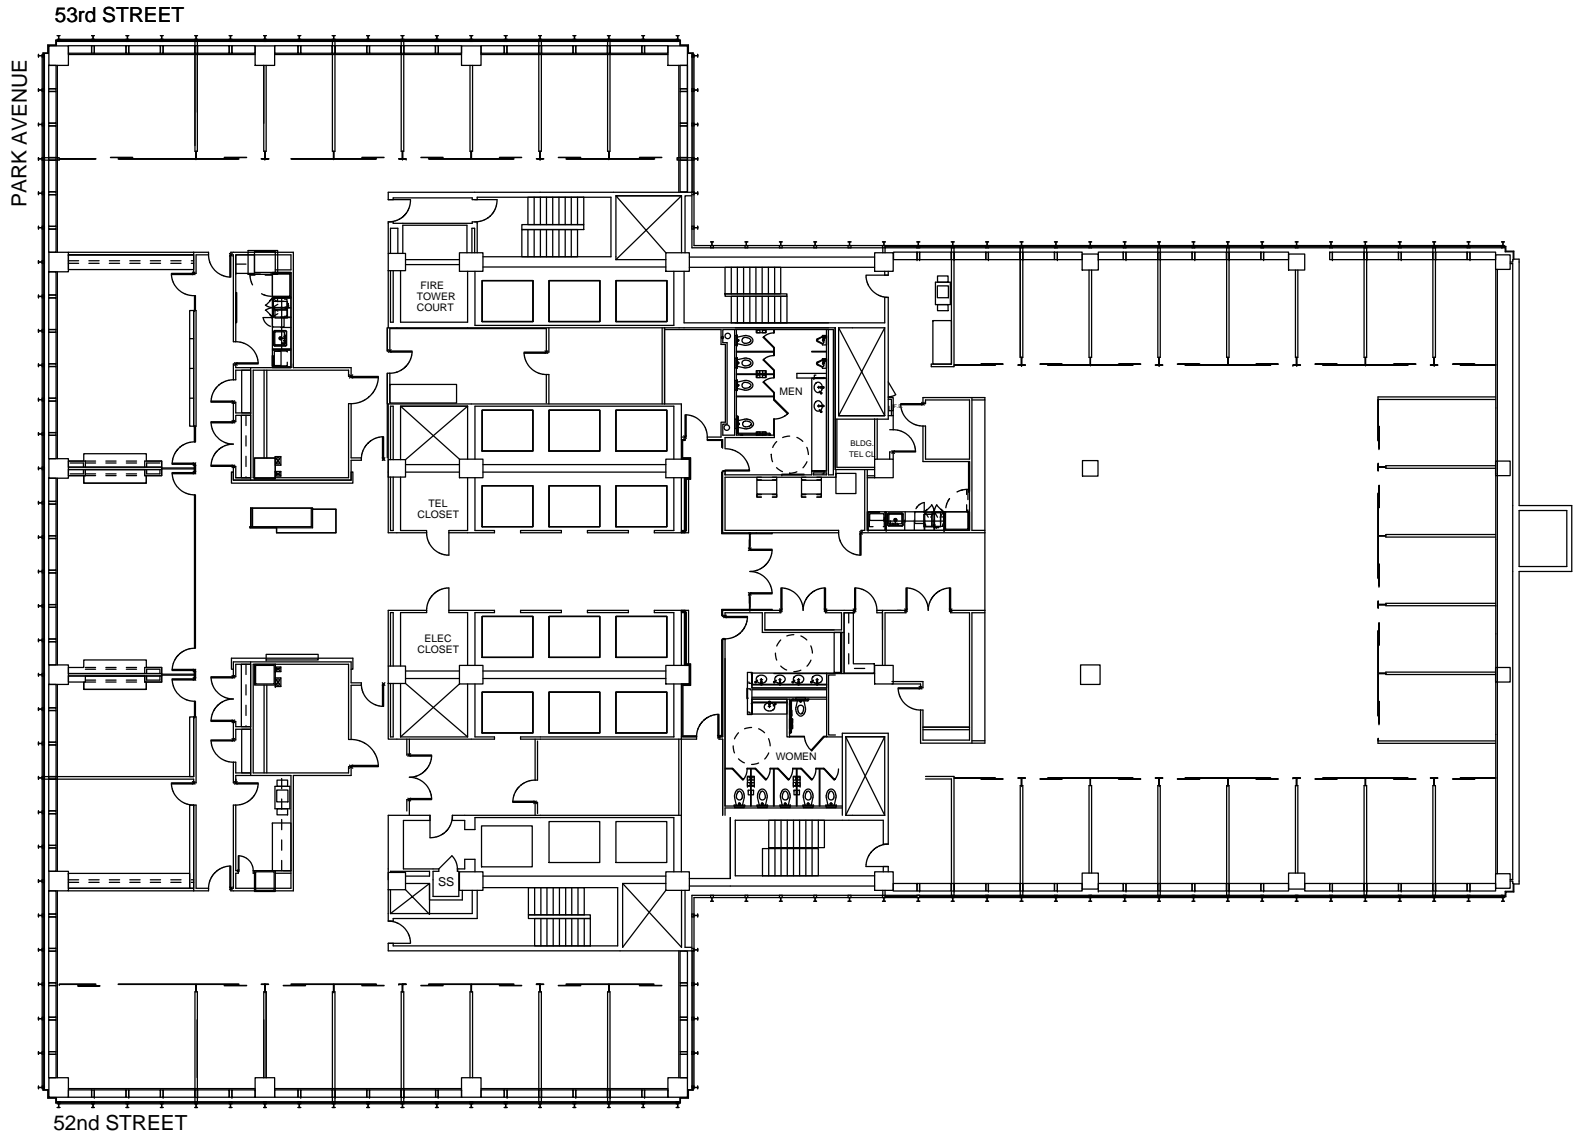

Date Printed: 5/8/2012





