


Date Printed: 5/8/2012





Date Printed: 5/8/2012

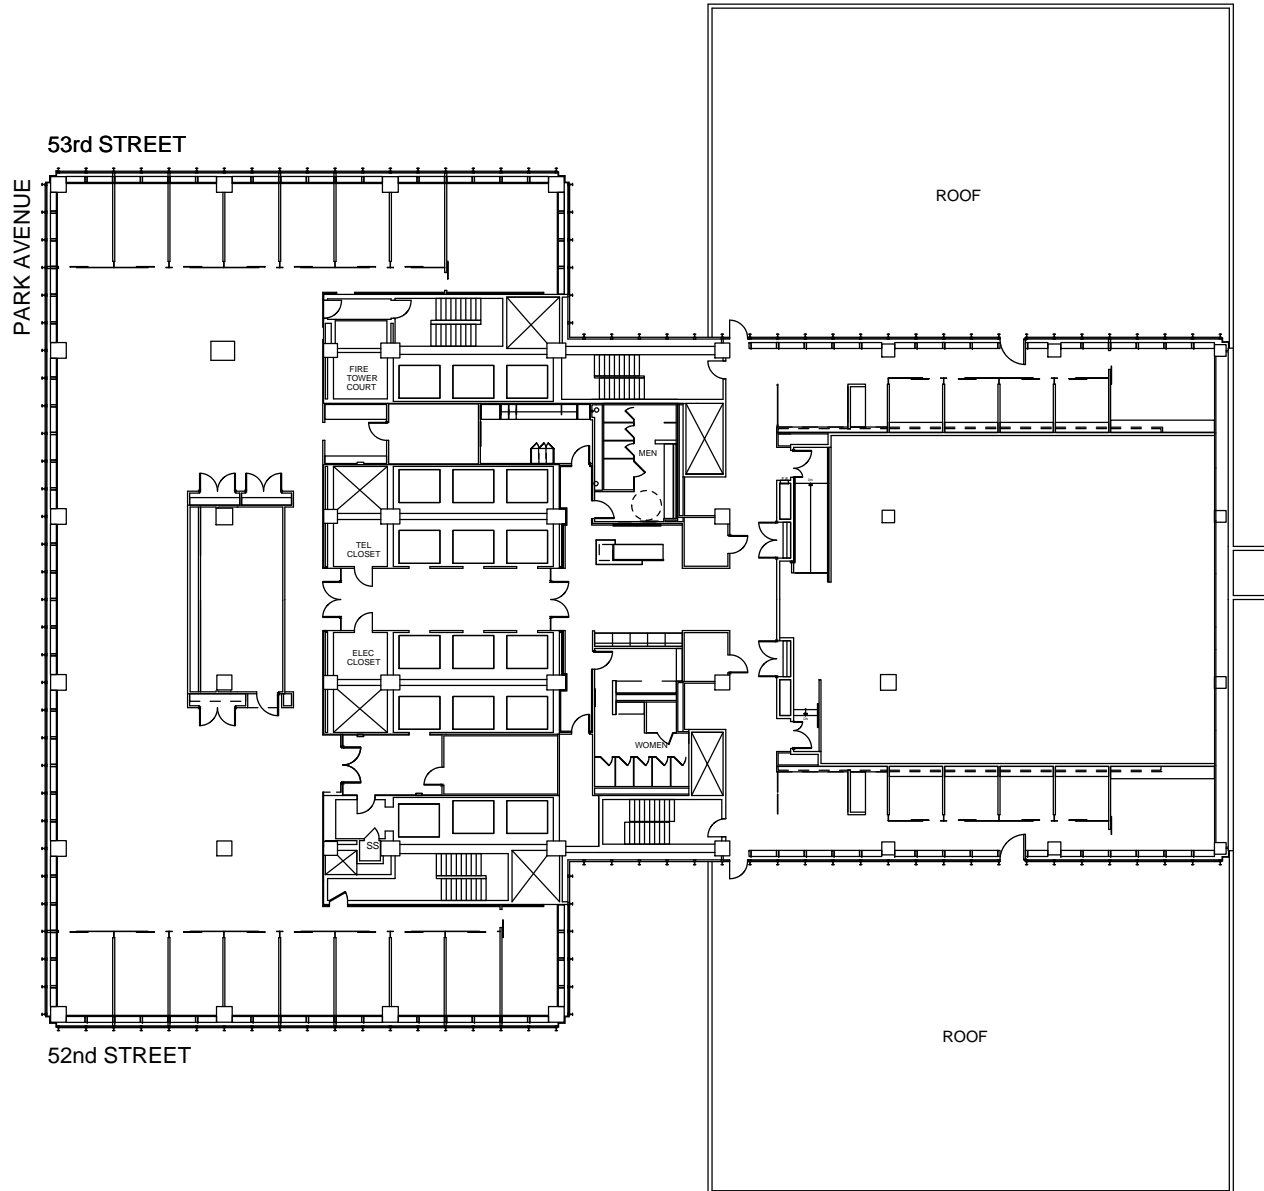

