
375 Park Avenue Floor 10







375 Park Avenue Floor 9

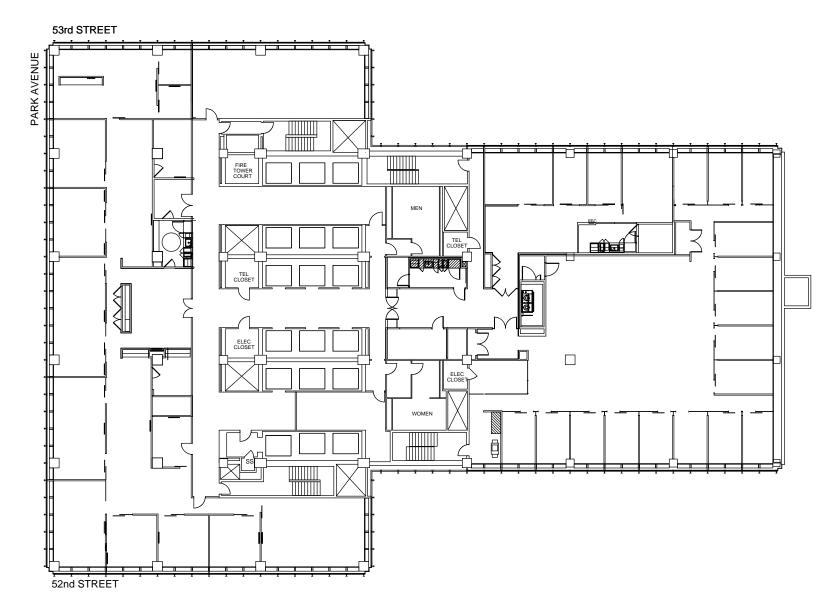