


Chrysler Building

Suite 1500 - 37,616 RSF

15th Floor

East 43rd St

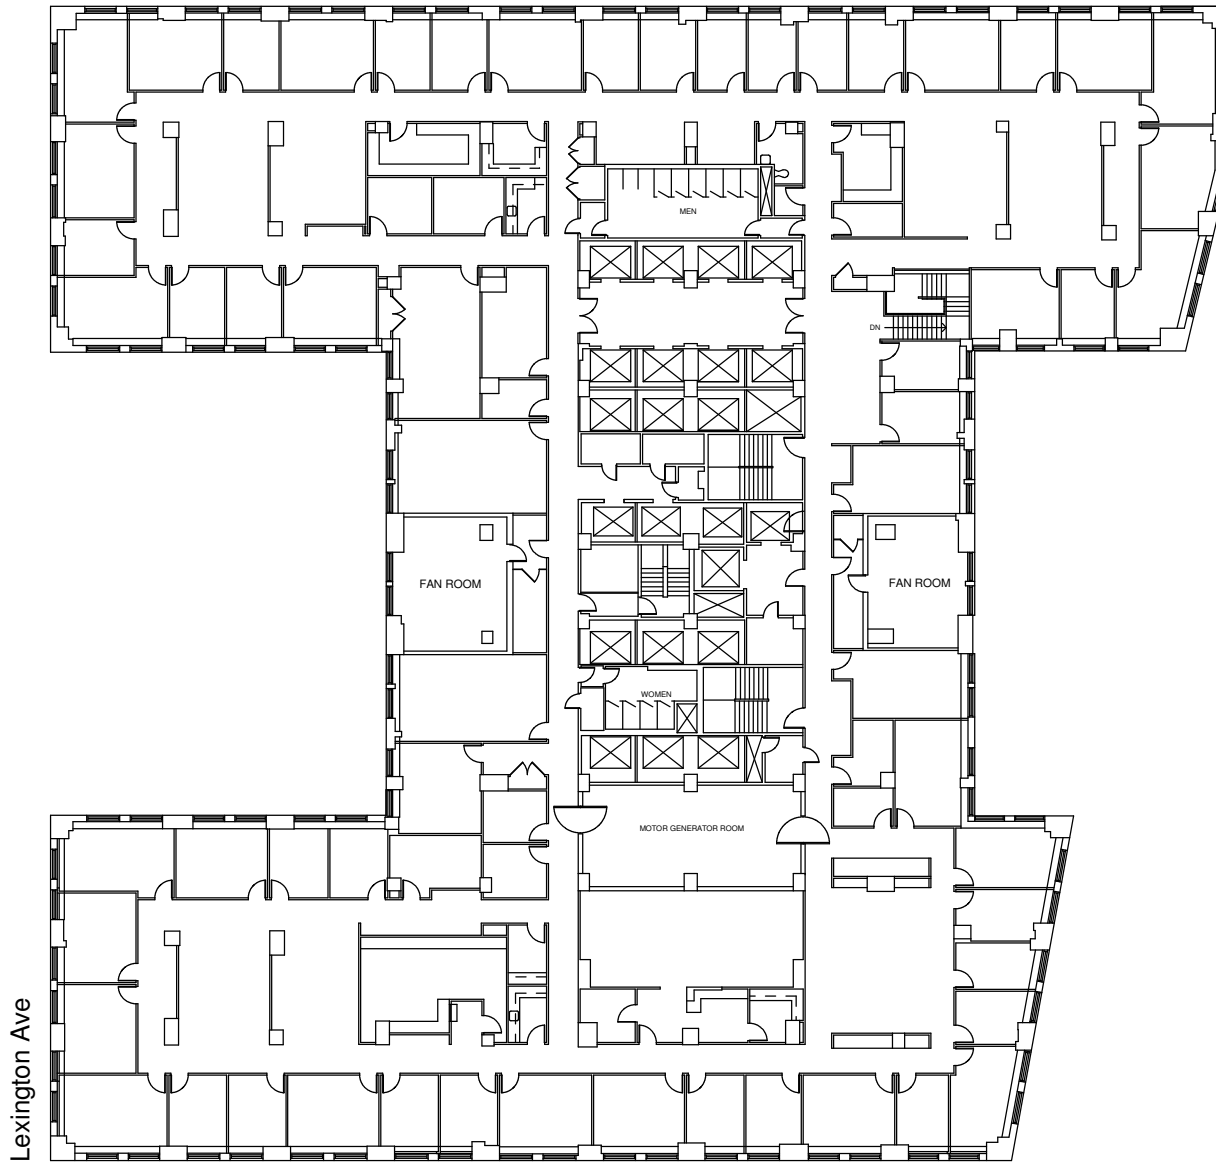

East 42nd St

Lexington Ave

Date Printed: 6/18/2019

RFR
RFR REALTY LLC

For complete listing, visit
www.rfrspace.com
www.rfrrealty.com




Not to scale. All dimensions and conditions are approximate and for information only.

Chrysler Building

Suite 1500 - 37,616 RSF

15th Floor

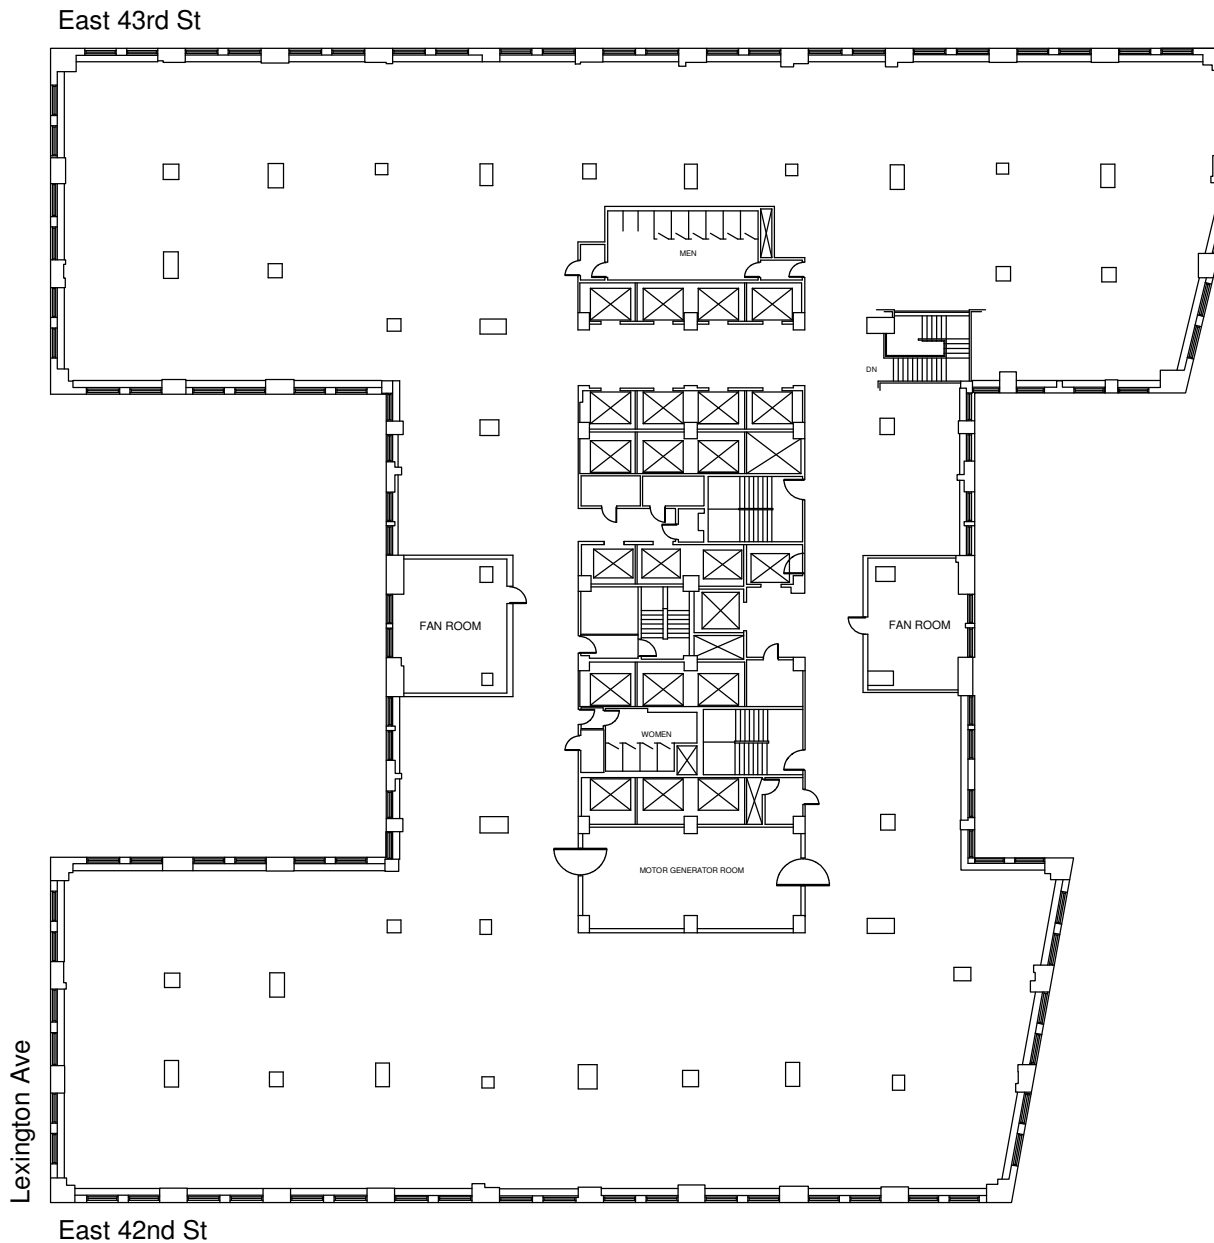

Date Printed: 4/9/2019

