


477 Madison Avenue

Suite 2100 - 8,010 RSF

Floor 21

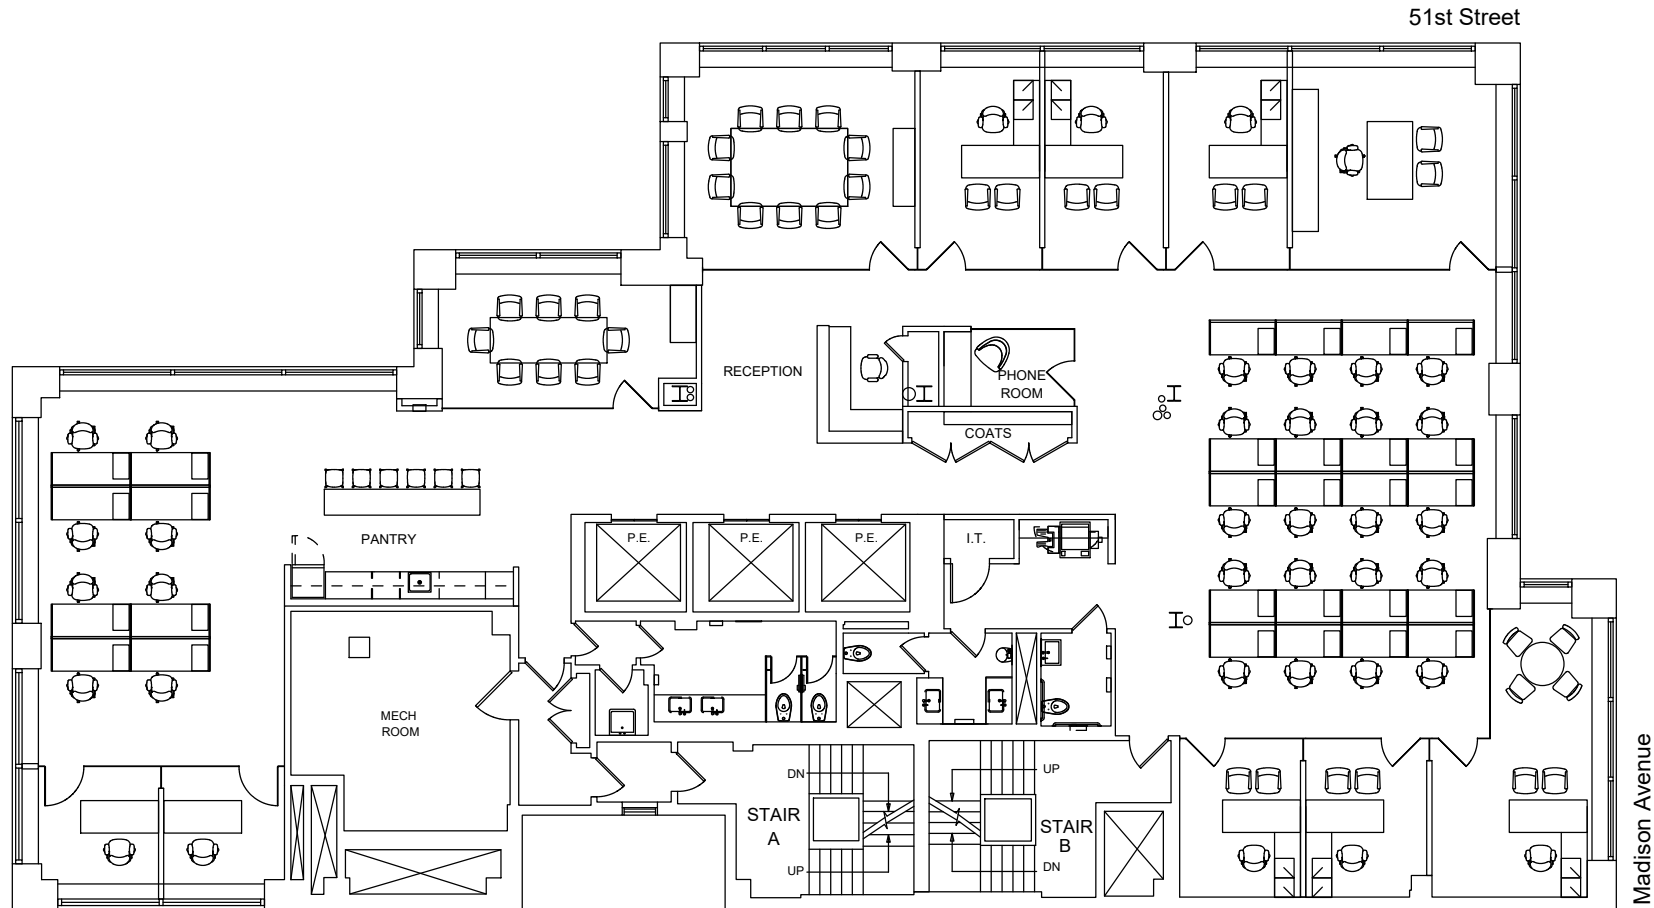

Date Printed: 1/24/2025

