


477 Madison Avenue

Suite 1000 - 18,038 RSF

Floor 10

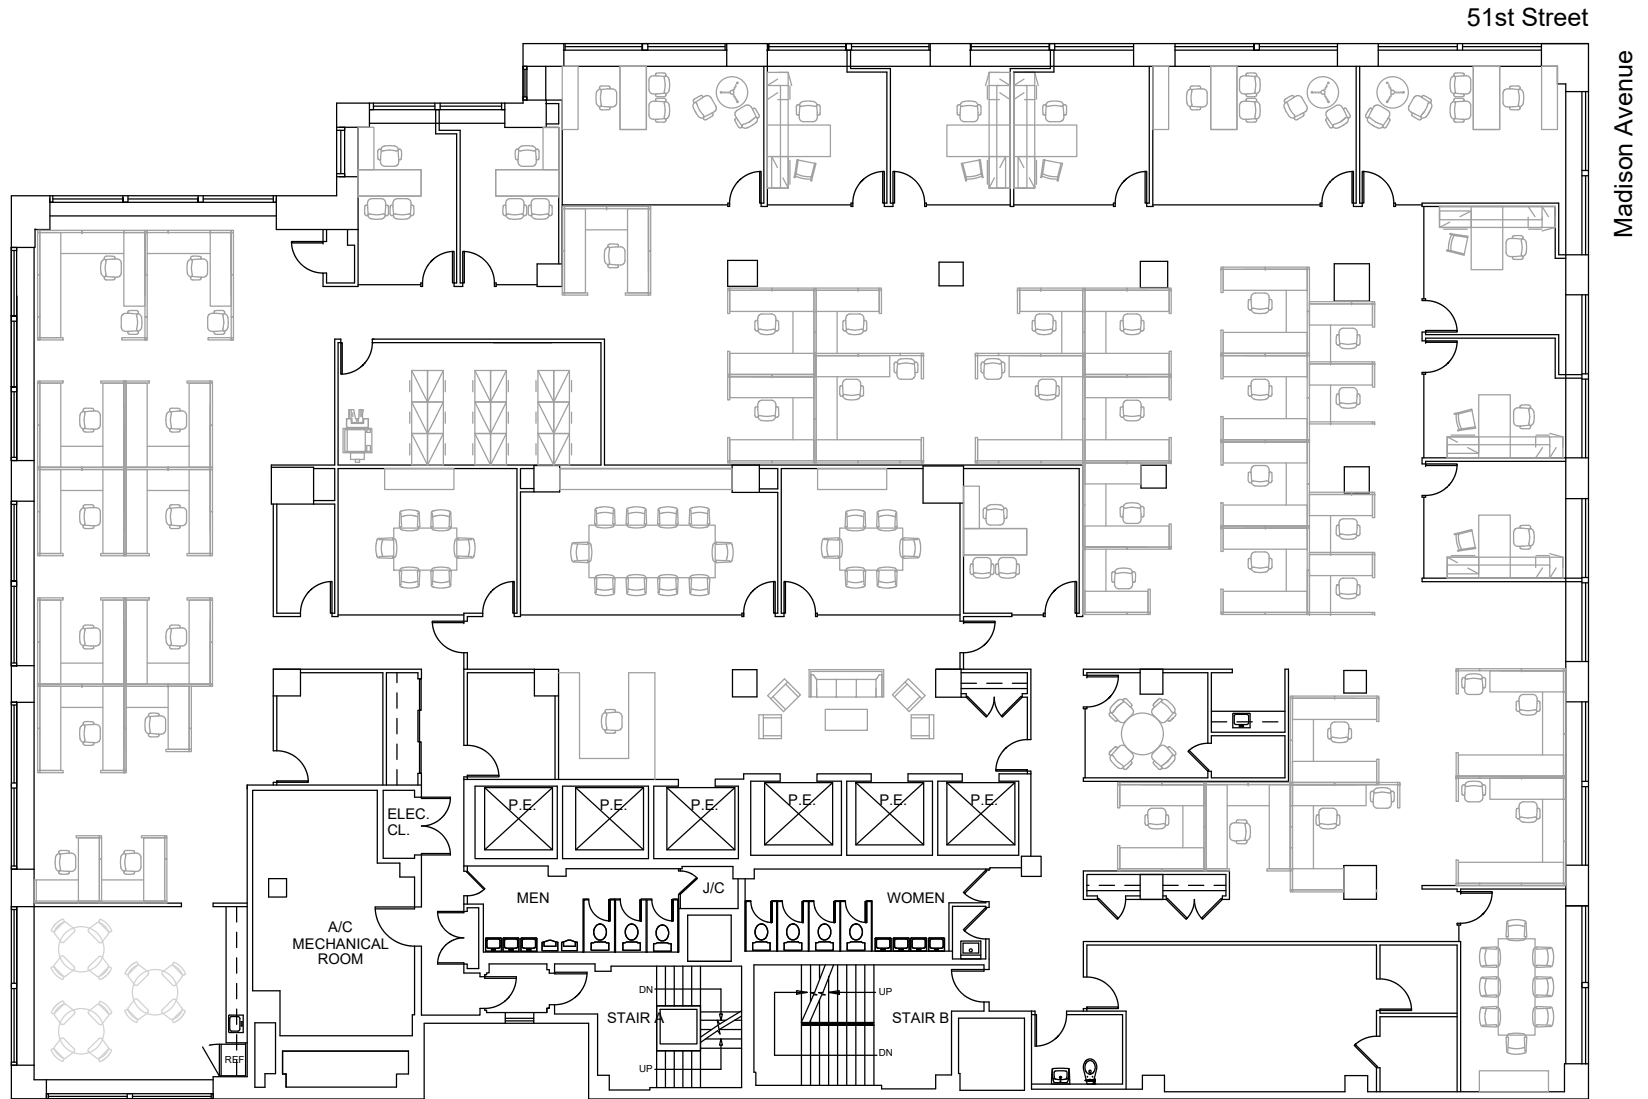

Date Printed: 3/25/2022

