


375 Park Avenue
Suite 1400 - 16,979 RSF
Office Intensive

Floor 14




Date Printed: 6/14/2023

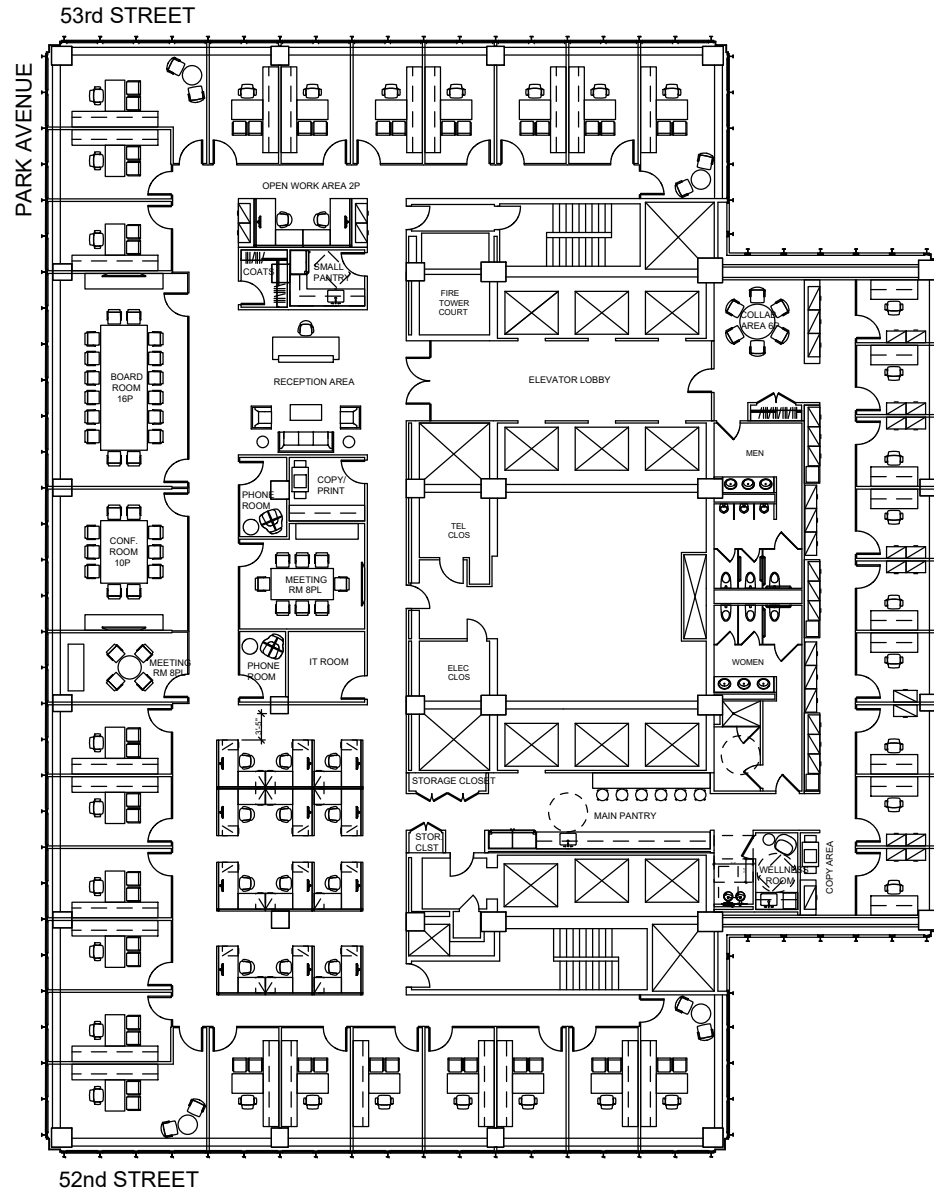

375 Park Avenue
Suite 1400 - 16,979 RSF
Trading Layout

Floor 14

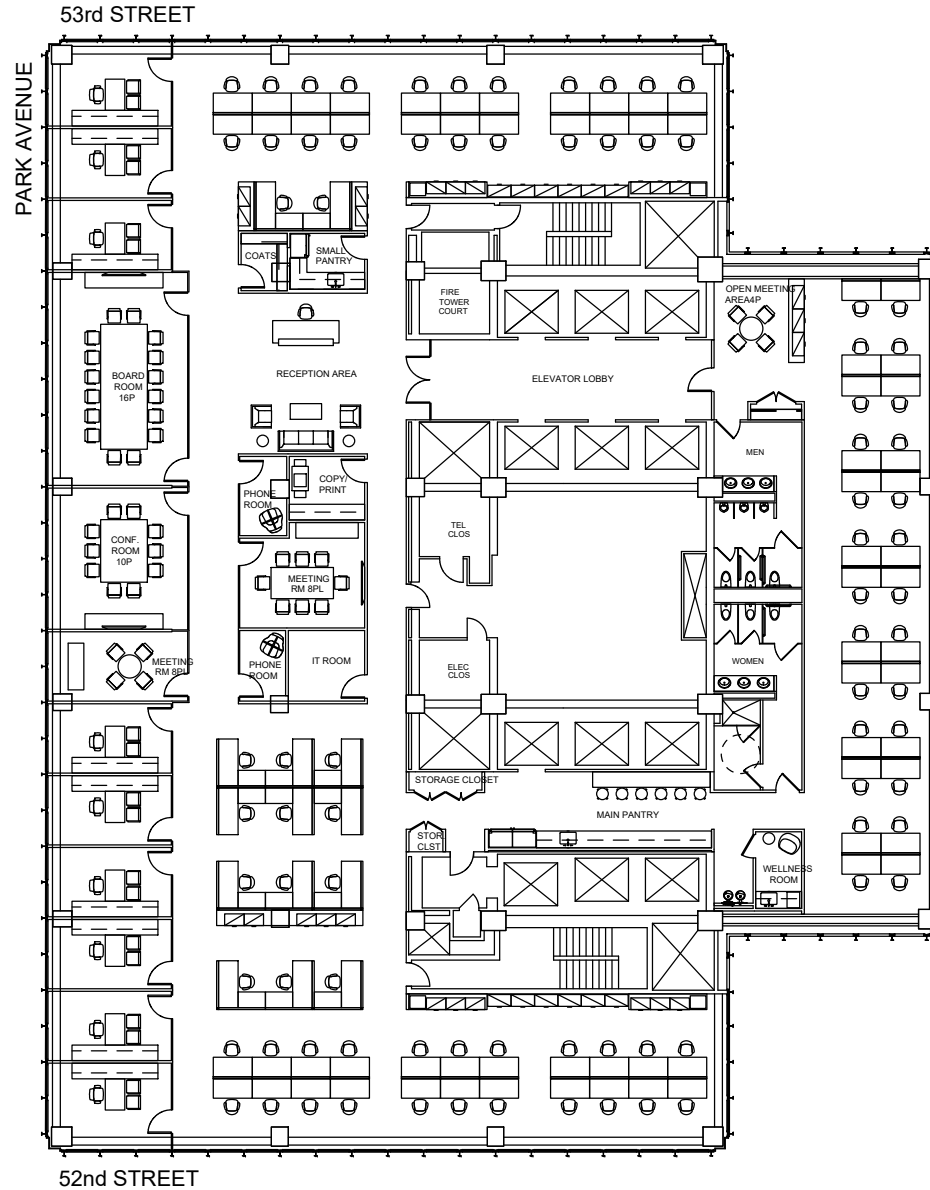


Date Printed: 6/14/2023



375 Park Avenue
Suite 1400 - 16,979 RSF
As Built

Floor 14

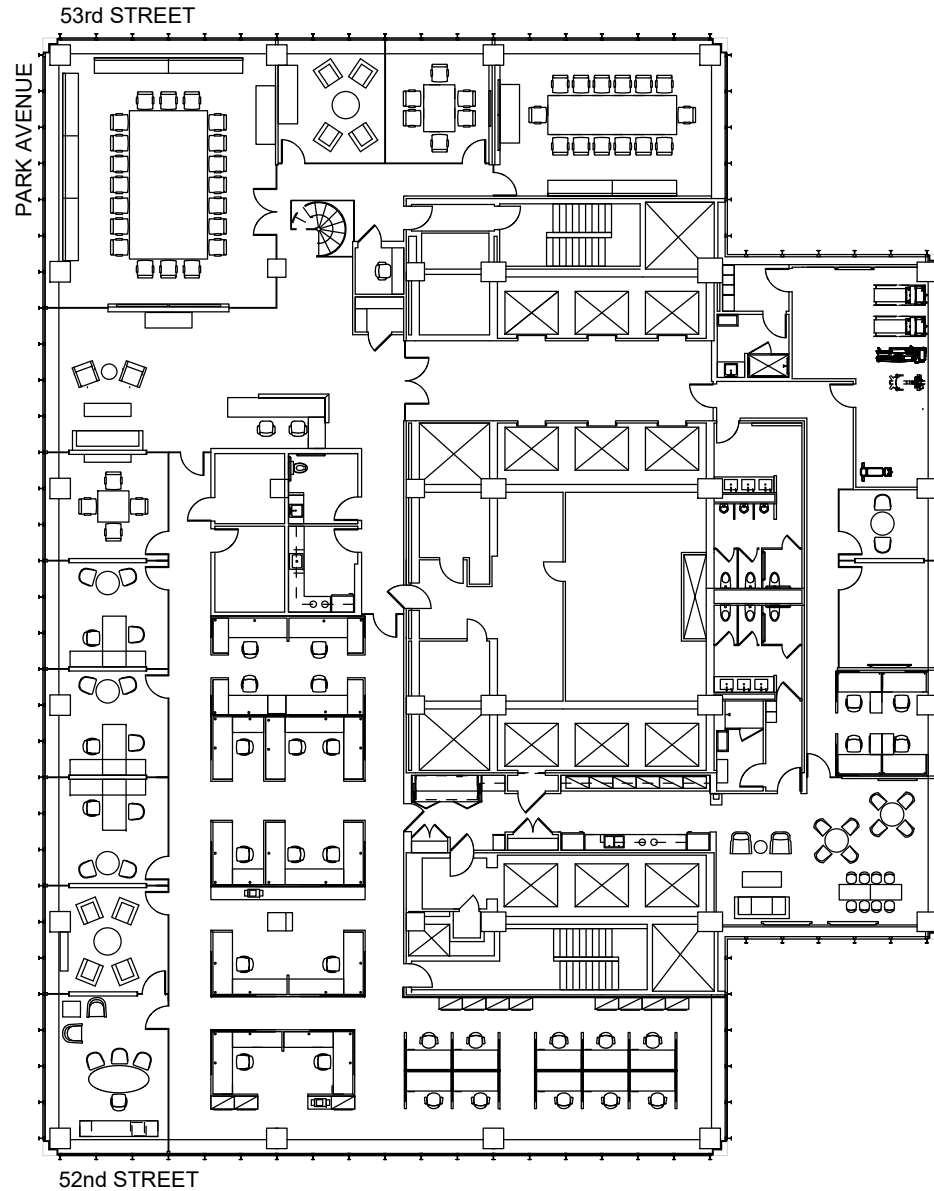


Date Printed: 4/27/2023



375 Park Avenue
Suite 1400 - 16,979 RSF
Core & Shell

Floor 14

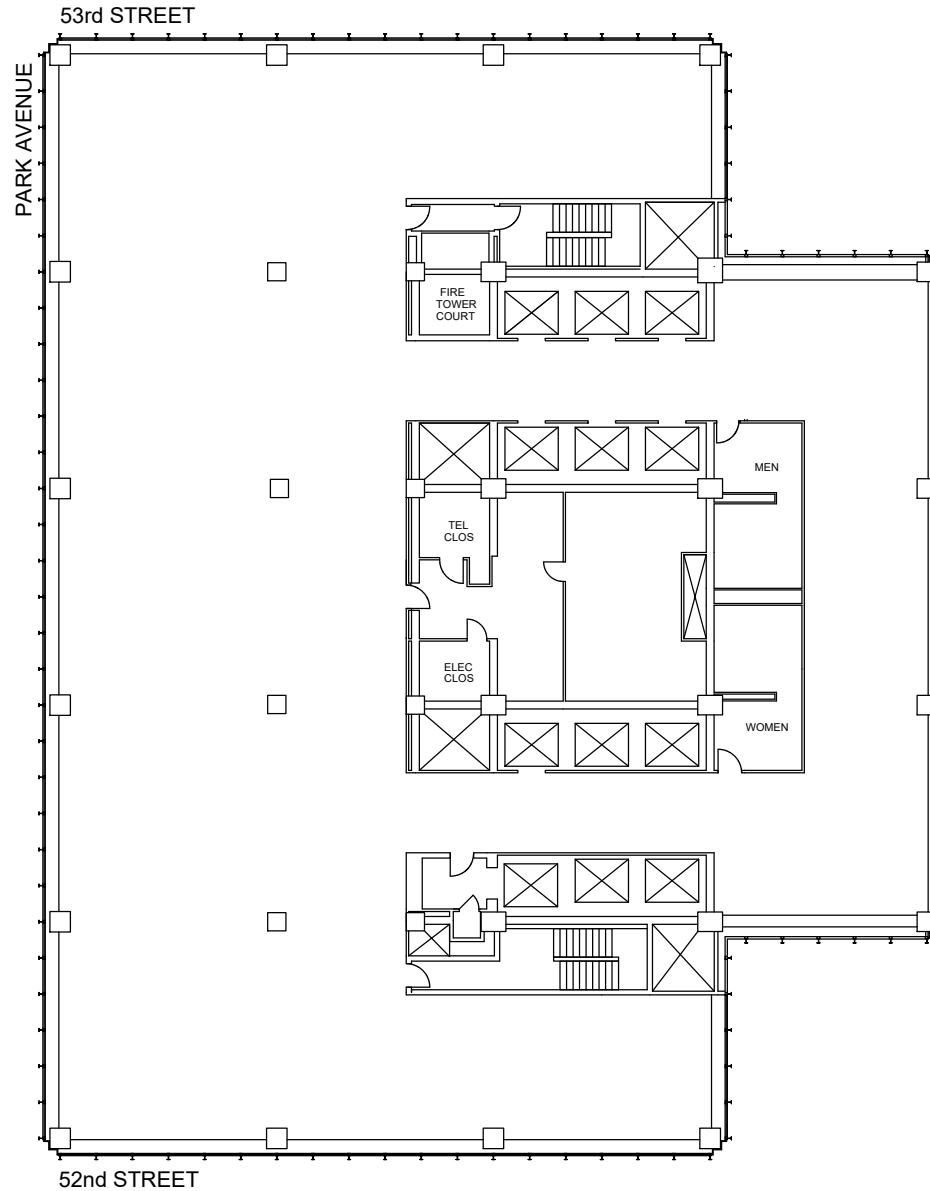

Date Printed: 2/16/2023

