
375 Park Avenue Suite 3302 - 5,700 RSF

١ $\overline{}$ AF \square T $\Box\Box$ $\Box\Box$ nr \bigcirc \bigcirc \bigcirc Q () ſ'n





For complete listing, visit www.rfrspace.com

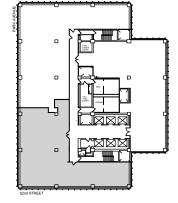

Not to scale. All dimensions and conditions are approximate and for information only.

Floor 33