


Chrysler Building

Suite 3800 - 11,069 RSF

38th Floor

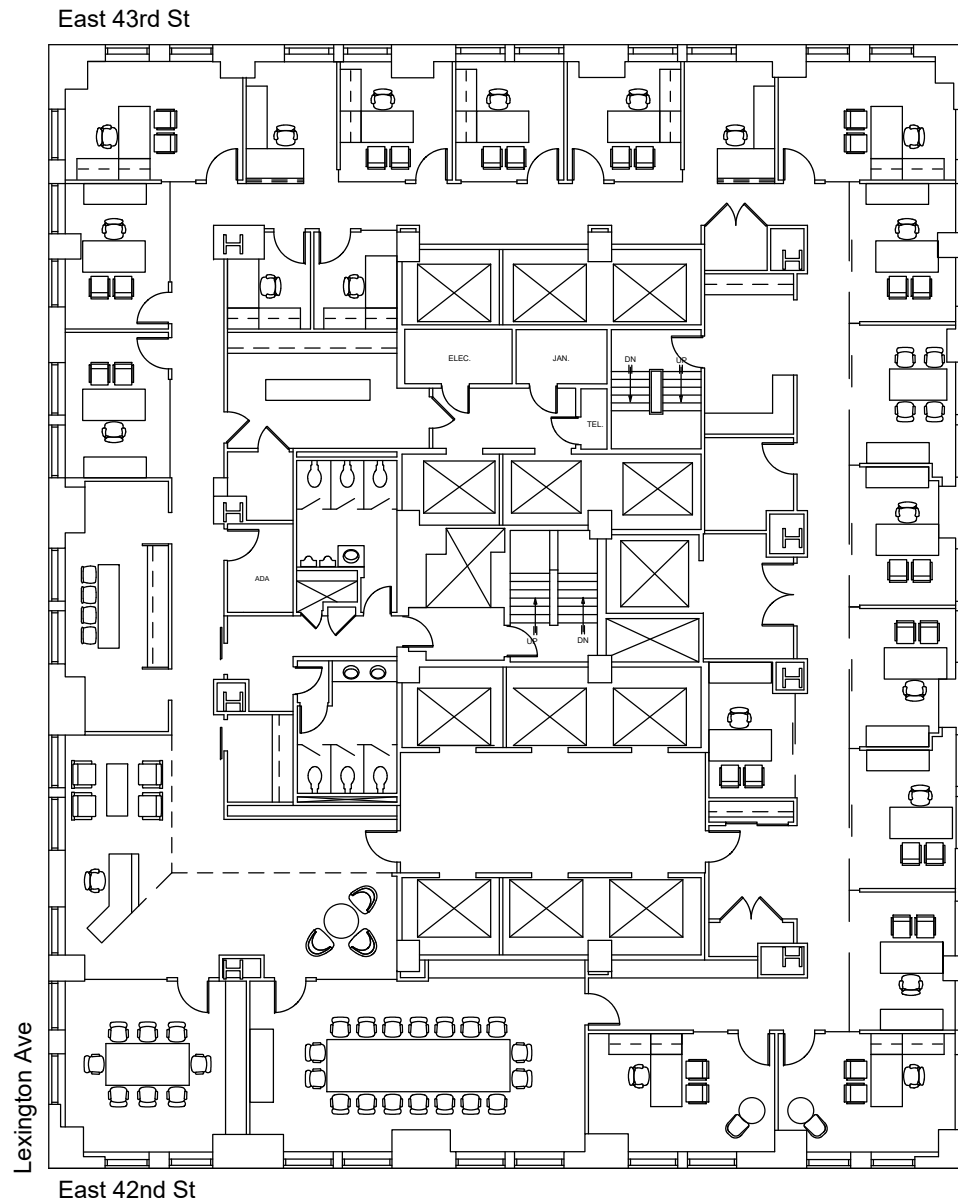

Date Printed: 8/9/2023

RFR
RFR REALTY LLC

For complete listing, visit
www.rfrspace.com
www.rfrrealty.com



Not to scale. All dimensions and conditions are approximate and for information only.