


# Chrysler Building

Suite 1500 - 37,616 RSF

# 15th Floor

East 43rd St

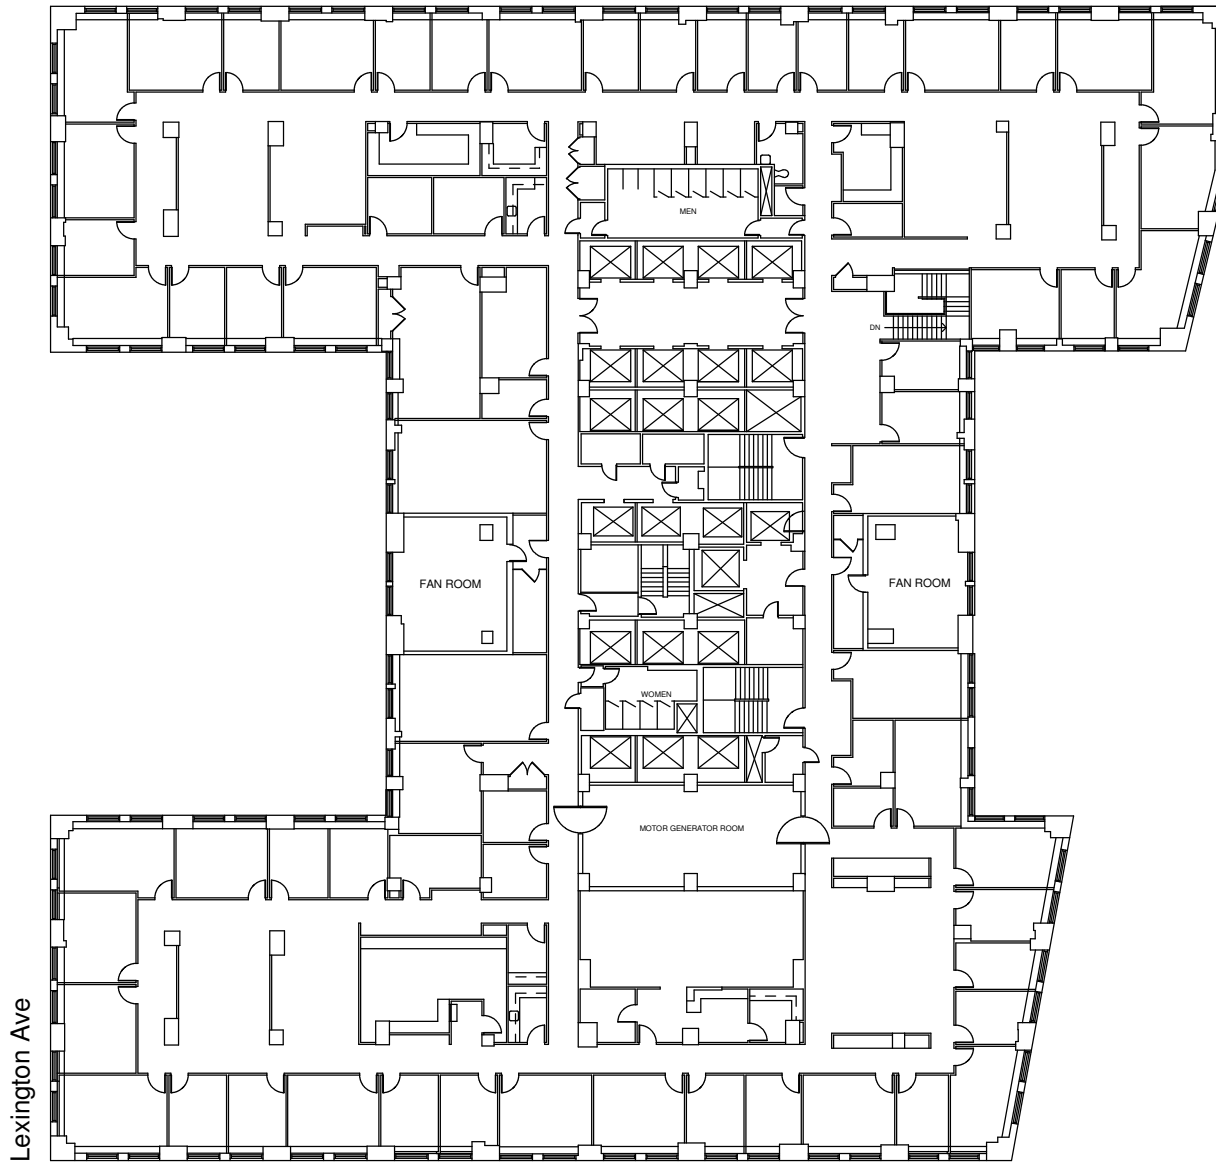

East 42nd St

Date Printed: 6/18/2019

**RFR**  
RFR REALTY LLC

For complete listing, visit  
[www.rfrspace.com](http://www.rfrspace.com)  
[www.rfrrealty.com](http://www.rfrrealty.com)



Not to scale. All dimensions and conditions are approximate and for information only.