475 Fifth Avenue
Suite 1900 - 8,013 RSF

Floor 19

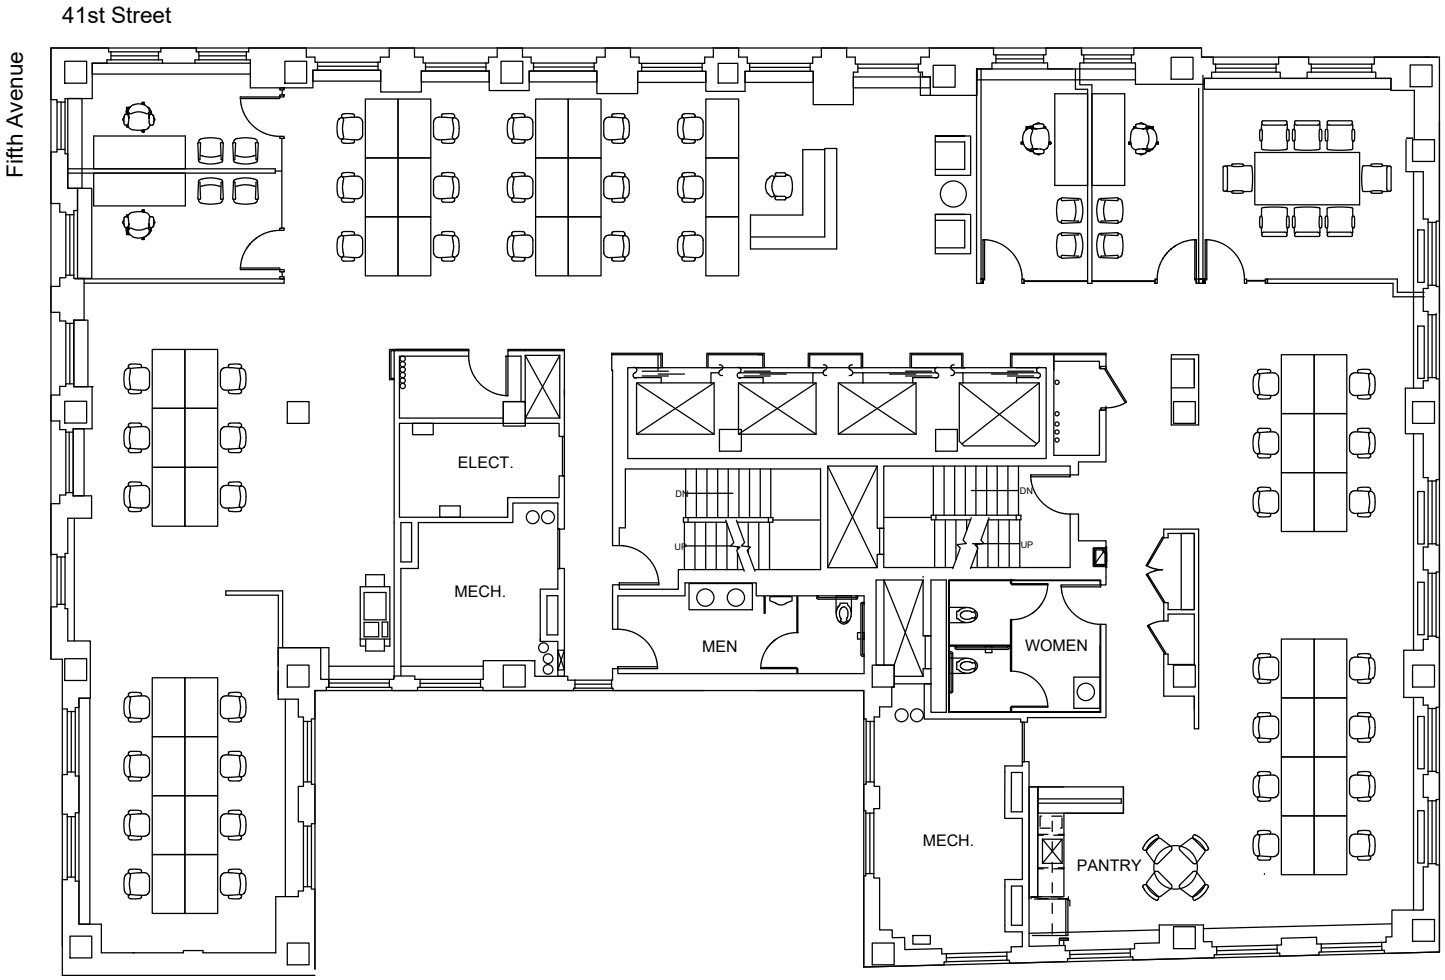

Date Printed: 6/2/2022

RFR
RFR REALTY LLC

For complete listings, visit
www.rfrspace.com

N

Not to scale. All dimensions and conditions are approximate and for information only.