375 Park Avenue

Floors 9 - 10

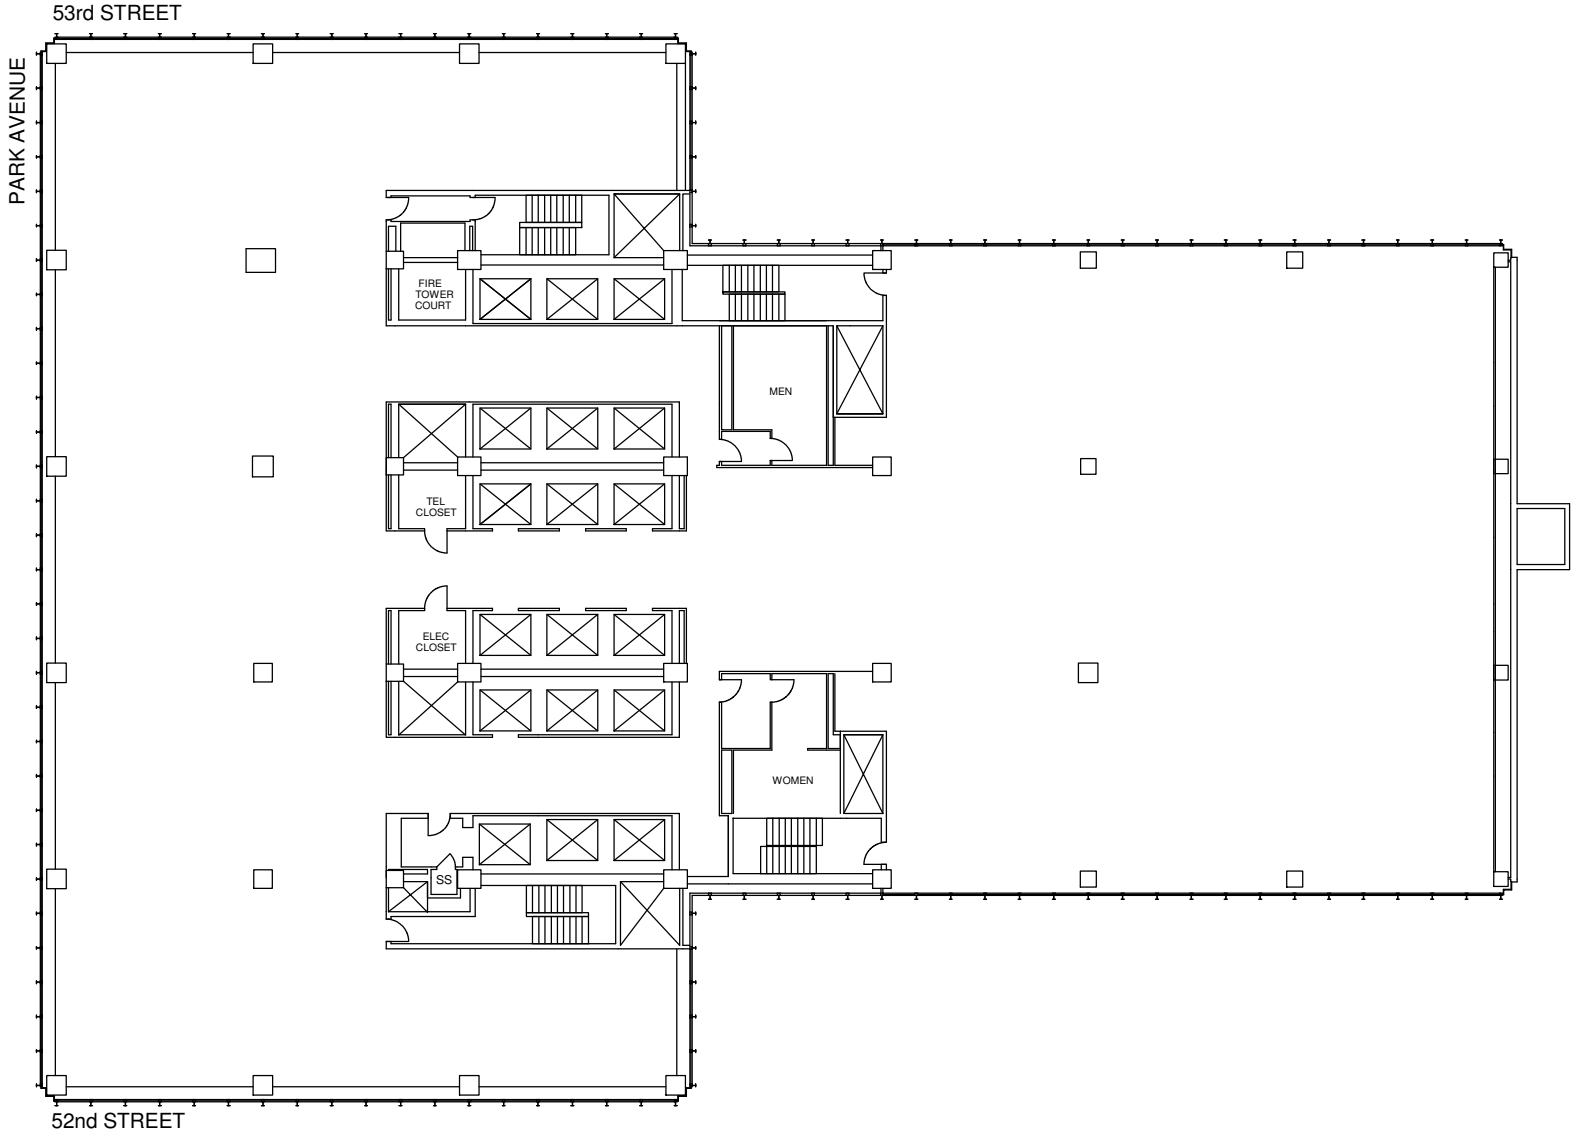

Date Printed: 7/18/2019

RFR

RFR REALTY LLC

For complete listing, visit
www.rfrspace.com

N

Not to scale. All dimensions and conditions are approximate and for information only.

375 Park Avenue

Floor 9

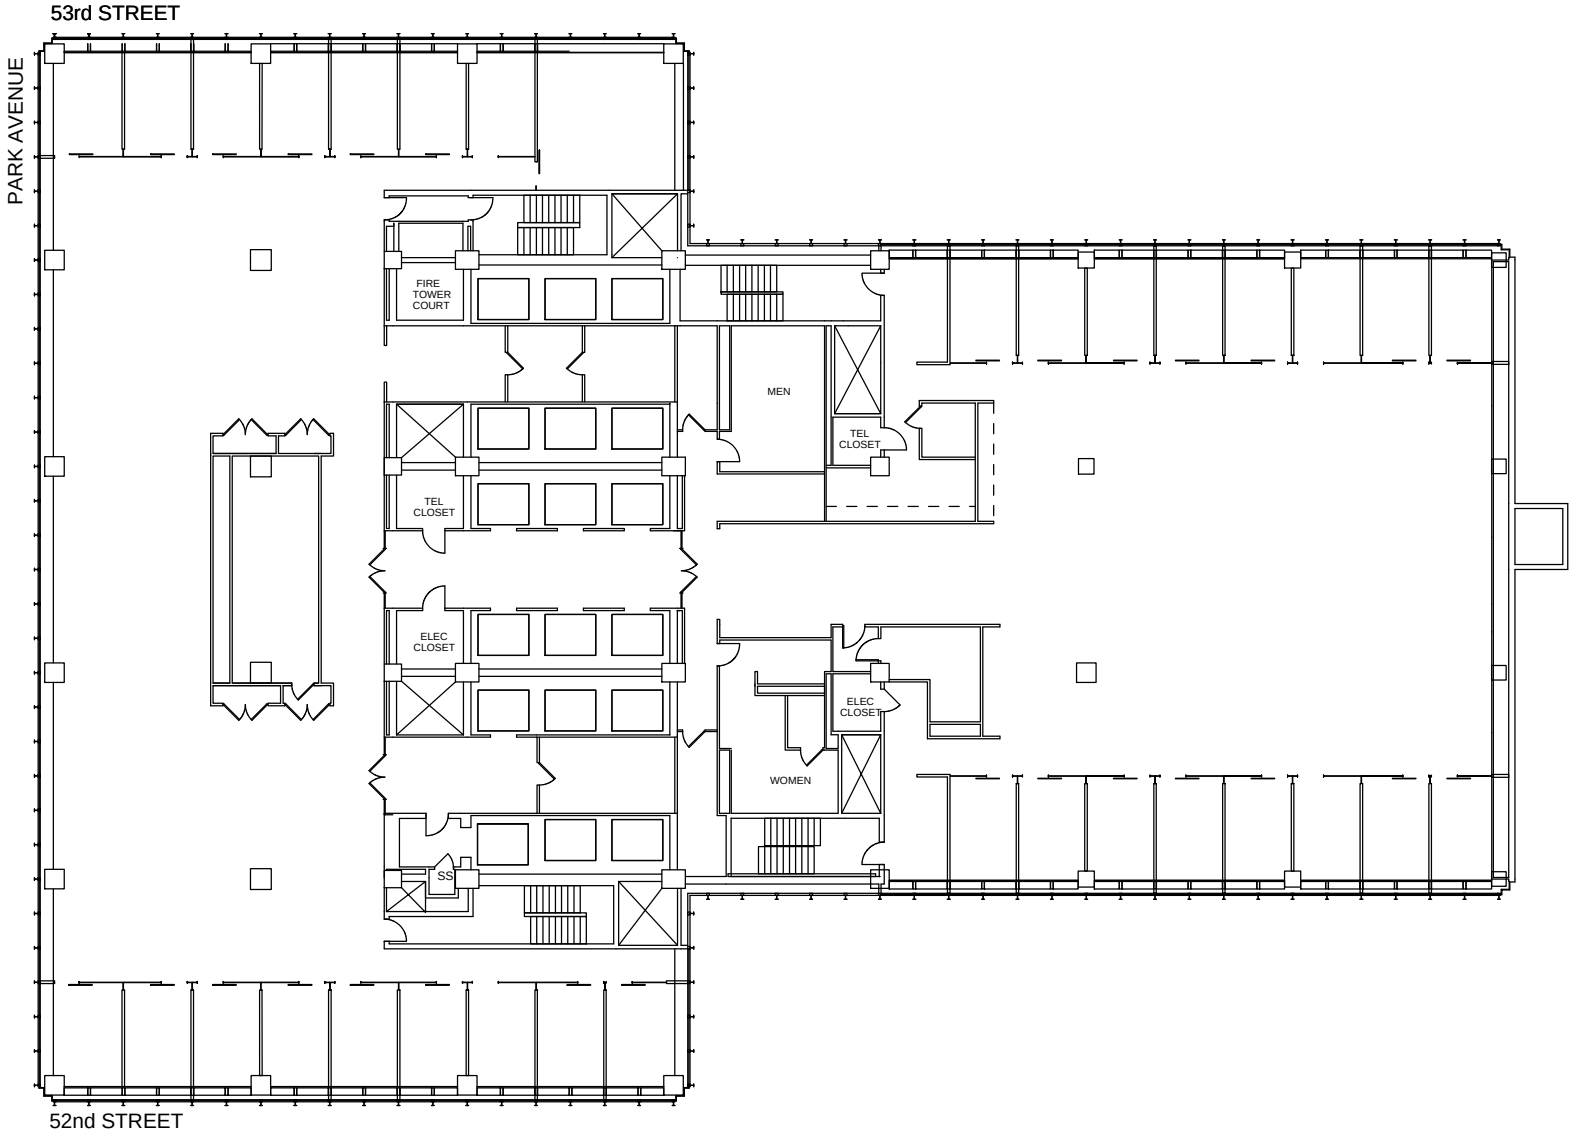

Date Printed: 5/8/2012

RFR
RFR REALTY LLC

For complete listing, visit
www.rfrspace.com

N

Not to scale. All dimensions and conditions are approximate and for information only.

375 Park Avenue

Floor 10

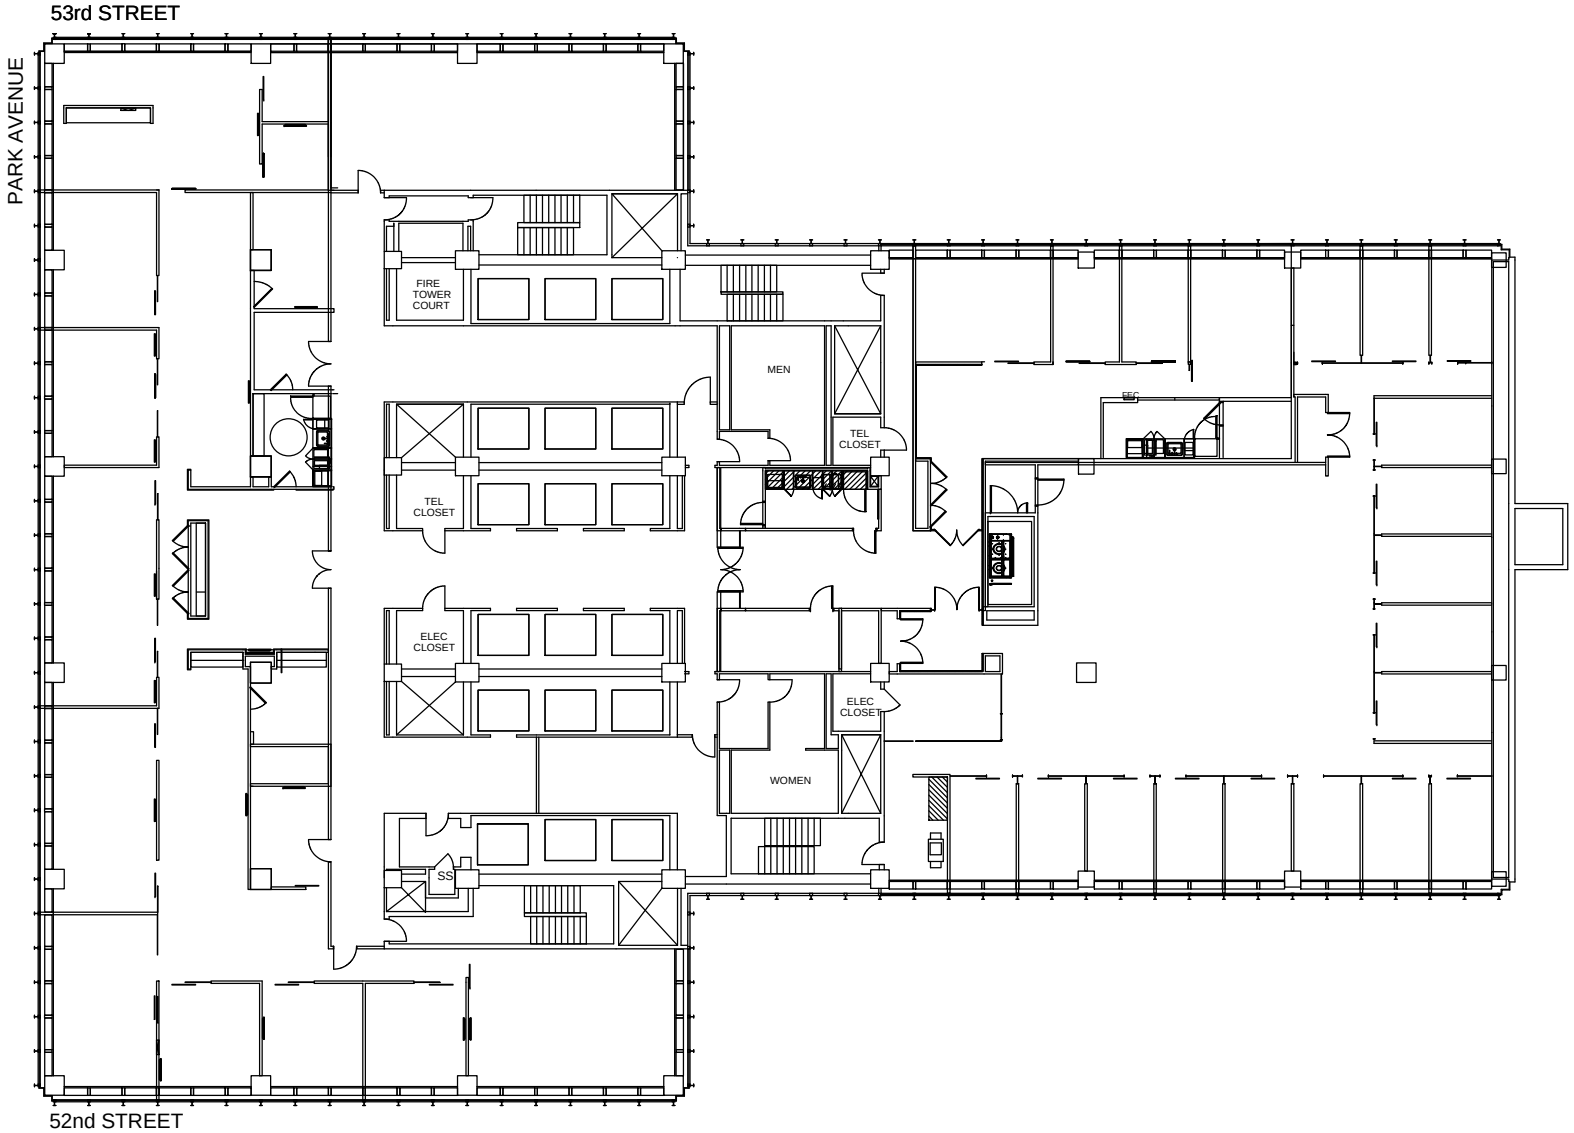

Date Printed: 5/8/2012

RFR
RFR REALTY LLC

For complete listing, visit
www.rfrspace.com

N

Not to scale. All dimensions and conditions are approximate and for information only.